




DATE \_\_\_\_\_

TOWN OF LEXINGTON — BOARD OF PUBLIC WORKS

SEWER DIVISION

Sketch of Service Here

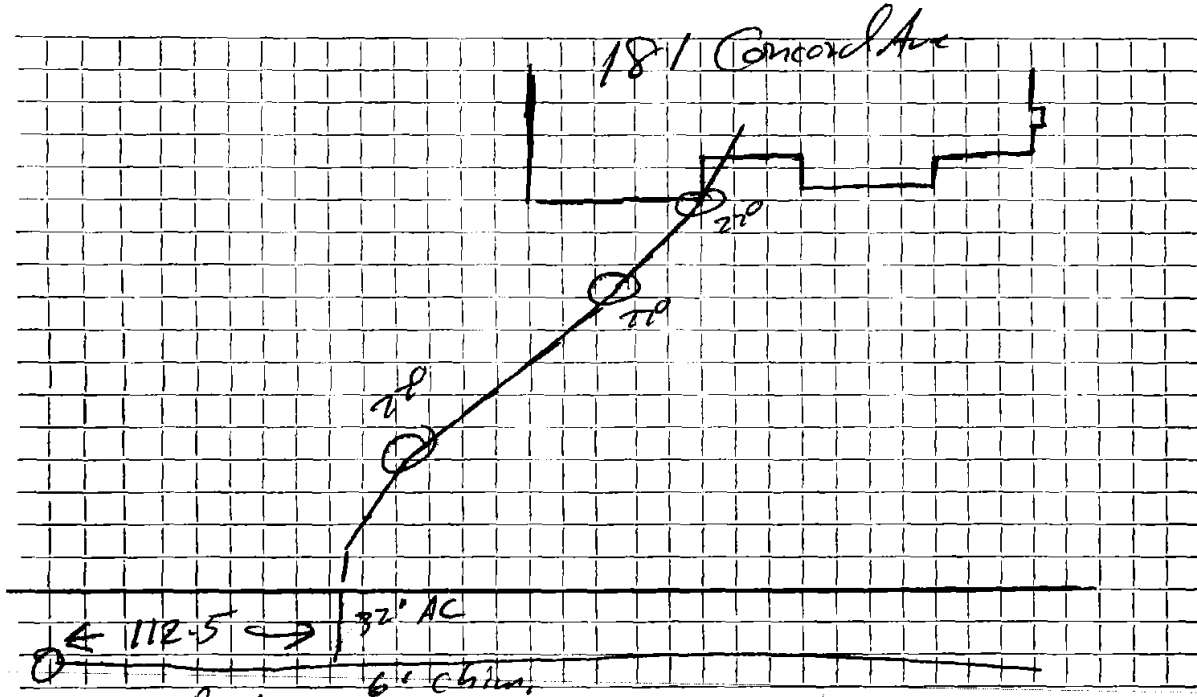

Connection made in Concord Ave Street. Work completed .....

Remarks: ..... 8'-6" deep st. back of sidewalk .....