

Name John Kuhn

Service No. 84

Address 190 Concord Avenue

Location

Kind of Pipe

Size

Size of Main

~~Repair or Renewal~~ — New Service Kel Scott #3040


Location Comm. 12/12/77

Date	Material	Amount	Total	Date	Amount
11-13-74	32' 6" Transite pipe @7.00		224.00	9-6-77	Deposit
0-11-77	38' 6" Transite pipe				
10-11-77	21' 4" C. I. pipe			8-15-77	
				15'	6" Transite
				1	6" Collar

DATE _____

TOWN OF LEXINGTON — BOARD OF PUBLIC WORKS

SEWER DIVISION

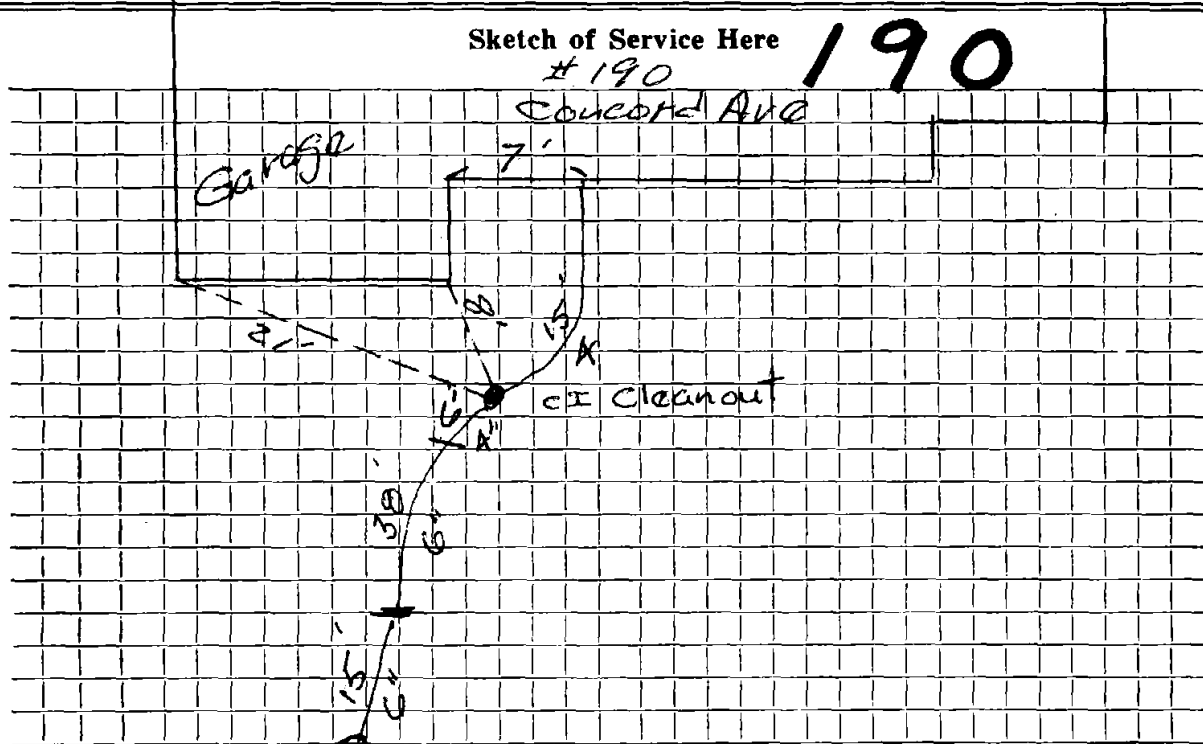

Connection made in Concord Ave Street. Work completed

Remarks: Service out of SMH

21'-4" CI

53'-6" AC