

Name Stephen H. Perry

Service No. 13

Address # 197 CONCORD AVE.

Location

Kind of Pipe

AC

Size

6"

Size of Main

8"

~~REPAIRS~~ New Service Griecci #3326

Location MAY 22 1978

Date	Material	Amount	Total	Date	Amount
Jul 16 76	35'-6" AG @ 70	350 -		4-15-78	350.00
5-18-78	65'-6" ACP; 7'-4" CT			7-16-76	
				35' 6" A.C.	

Name

Service No.

Address

197 Concord Ave

Location

Kind of Pipe

Size

Size of Main

Repair—Renewal—New Service

Location

Date

Material

Amount

Total

Date

Amount

10-26-00

5'-4" PVC

3'-6" PVC


1-6" AC-PVC Adapt

1-4x6 PVC-PVC Adapt

DATE 11-14-00

TOWN OF LEXINGTON — BOARD OF PUBLIC WORKS
SEWER DIVISION

Sketch of Service Here

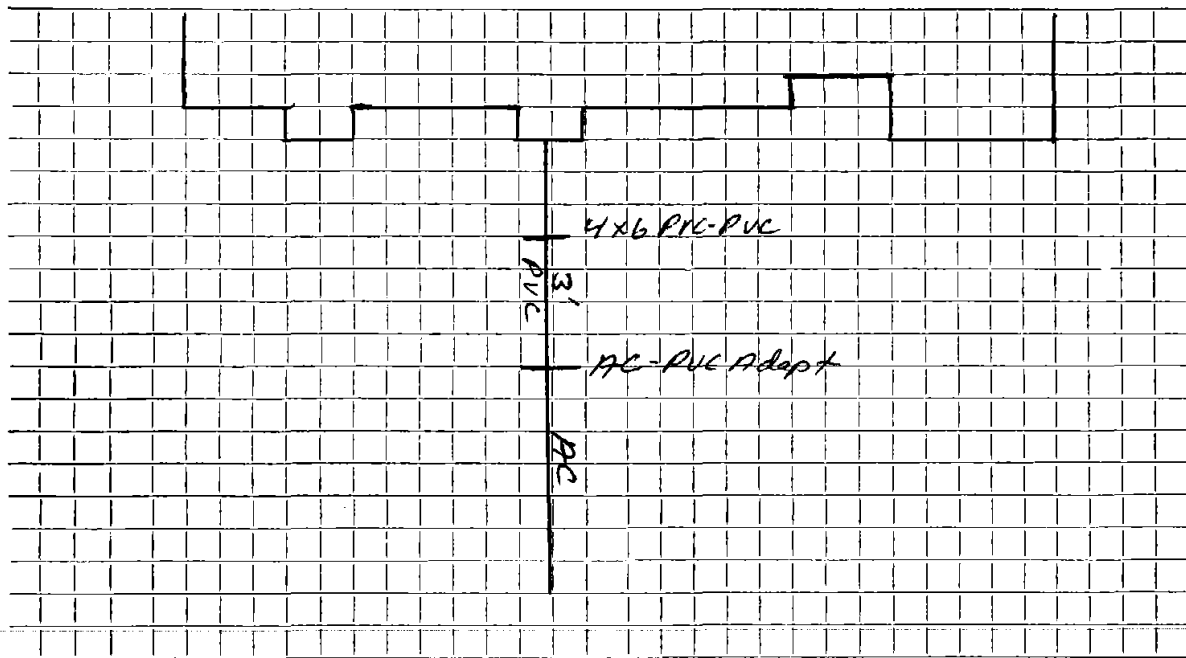


Connection made in Street. Work completed ..10:26:00.....

Remarks:
.....

DATE July 16, 1976

TOWN OF LEXINGTON — BOARD OF PUBLIC WORKS
SEWER DIVISION

Sketch of Service Here **197**

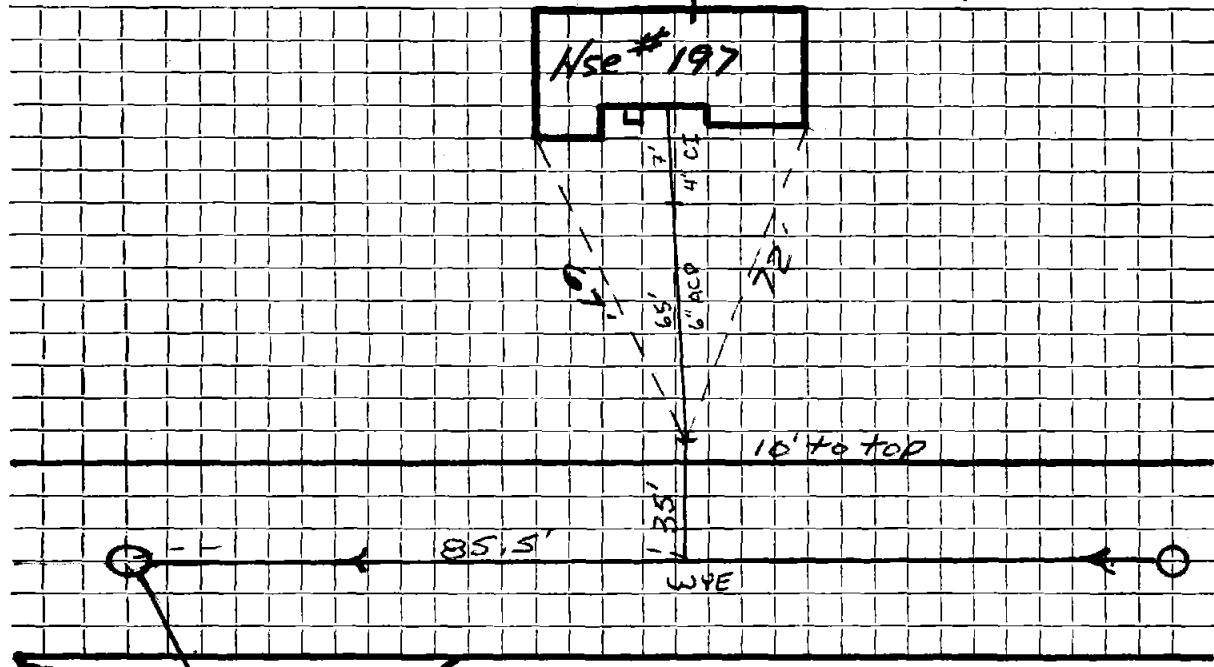

Connection made in CONCORD AVE Street. Work completed

Remarks: