

Name Oscar Garabedian

Service No. 23

Address # 203 CONCORD AVE

Location JUL 24 1978

Kind of Pipe AC Size 6" Size of Main 8"

~~Repair~~ ~~Renewal~~ New Service Valeri #3067


Location

Date	Material	Amount	Total	Date	Amount
<del>JUL 22 76</del>	<del>38'-6" AC @ \$10</del>	<del>380 -</del>		<del>6-9-78</del>	<del>380.00</del>
6-9-78	29'-6" AC; 5'-4" CI			7-22-76	
				38' 6" A.C.	

DATE July 22, 1976

TOWN OF LEXINGTON — BOARD OF PUBLIC WORKS  
SEWER DIVISION

Sketch of Service Here **203**

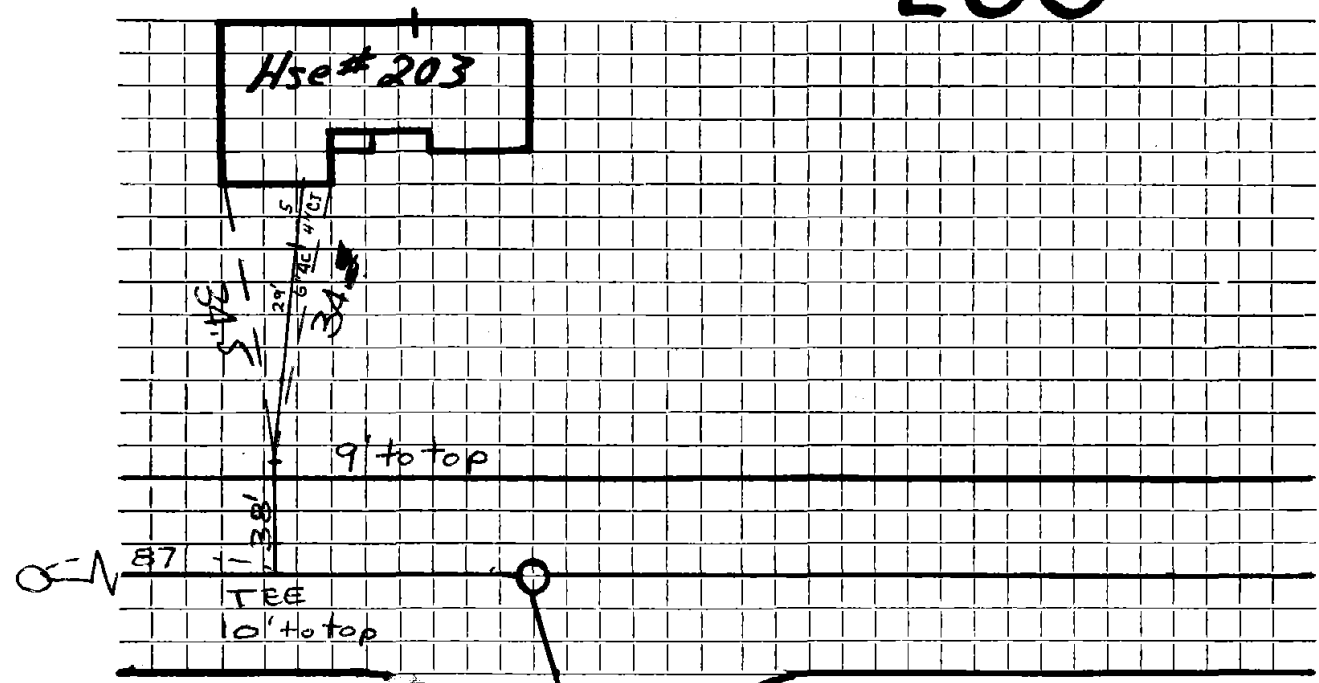

Connection made in CONCORD AVE ..... Street. Work completed .....

Remarks: .....  
.....  
.....