


DATE July 20, 1976

TOWN OF LEXINGTON — BOARD OF PUBLIC WORKS
SEWER DIVISION

Sketch of Service Here **211**

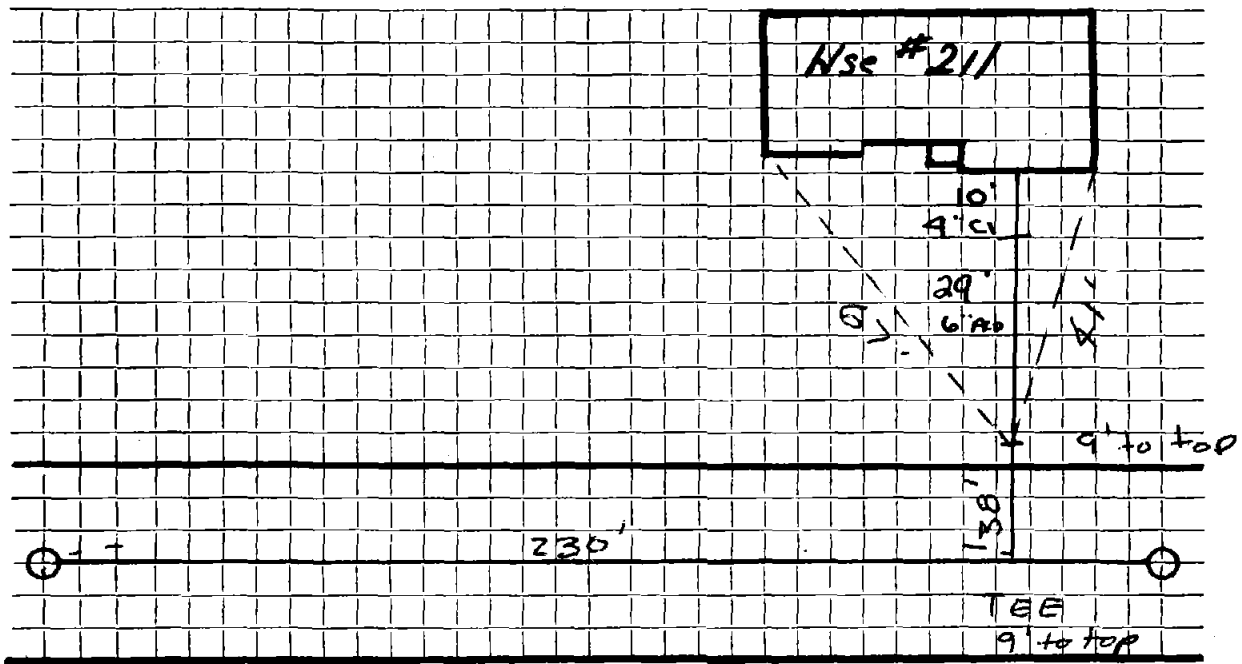

Connection made in CONCORD AVE Street. Work completed

Remarks:

