


DATE 6/8/2023

TOWN OF LEXINGTON — BOARD OF PUBLIC WORKS

SEWER DIVISION

Sketch of Service Here

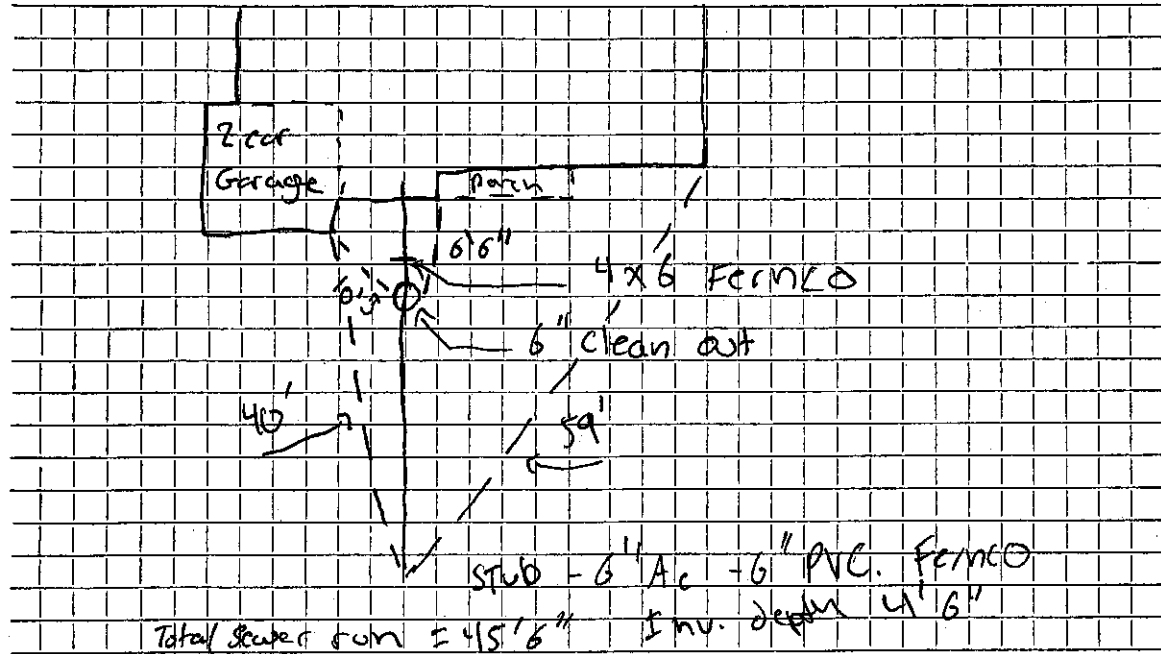

Connection made in 212 concord ave Street. Work completed

Remarks: J.M. McLaughlin, J.N.C.