

Name

Service No.

Address # 216 CONCORD AVE.

Location

Kind of Pipe AC

Size 6"

Size of Main 8"

Repair—Renewal—New Service


Location

Date	Material	Amount	Total	Date	Amount
Jul 12 76	11' 6" AC @ \$10	110 -			
		1-11-00			
				7-12-76	
				11' 6" A.C.	
1-11-00	RENEW SERVICE				
	1 CYG FENOCO PVC TO AC				
	30' 6" PVC				
	6' 4" CAST				

DATE July 12, 1976

TOWN OF LEXINGTON — BOARD OF PUBLIC WORKS
SEWER DIVISION

Sketch of Service Here **216**

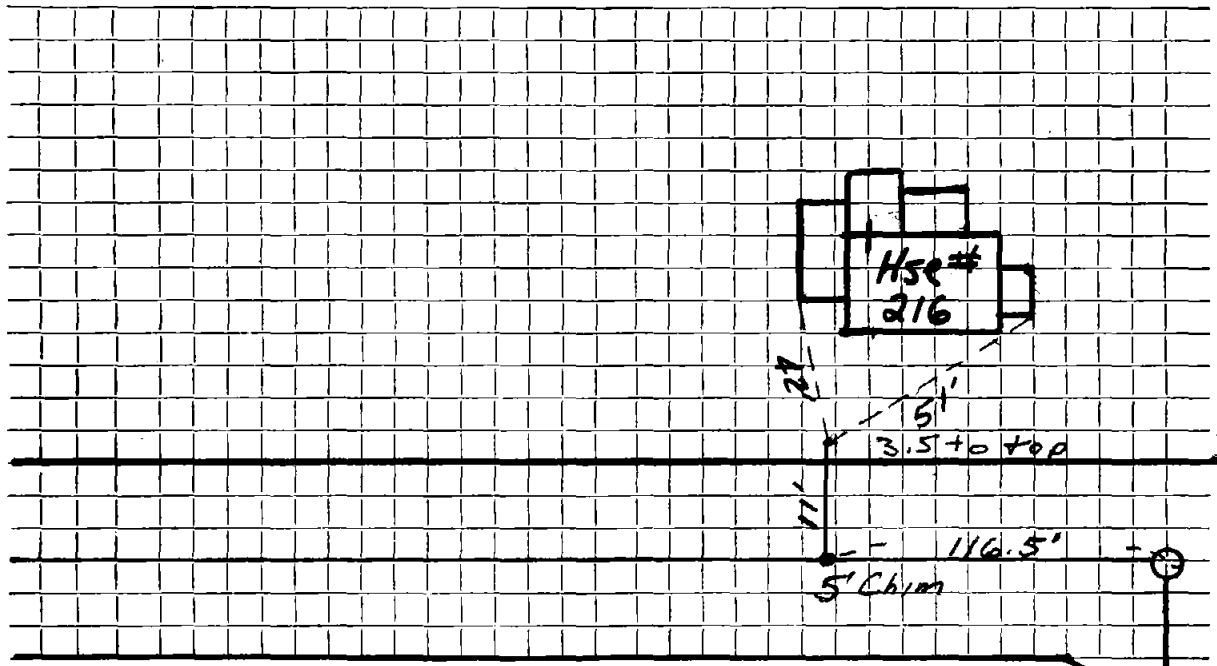

Connection made in CONCORD AVE Street. Work completed

Remarks: