

Name Eric H. & Signe K. Roos

Service No. 95

Address 217 Concord Avenue

Location

Kind of Pipe

Size

Size of Main

~~Repair/ Renewal~~ — New Service

WO # 8025

Location

Comm 10-28-63


Date	Material	Amount	Total	Date	Amount
8-8-63	Labor	93.43		8-6-63	300.00
8-9-63	"	93.43	186.86	11-8-63	65.44
	10% O.H.	18.69	205.55		365.44
	90' 6" Transite pipe @.82		73.80		
	1 6" Transite Elbow		4.09		
	8 yds. Loam @3.00		24.00		
	6 hrs. Town Shovel @6.50		39.00		
	3 hrs. Trucking @3.00		9.00		
	10 x 3 Patch		10.00		
			365.44		

DATE _____

TOWN OF LEXINGTON — BOARD OF PUBLIC WORKS
SEWER DIVISION

Sketch of Service Here

217

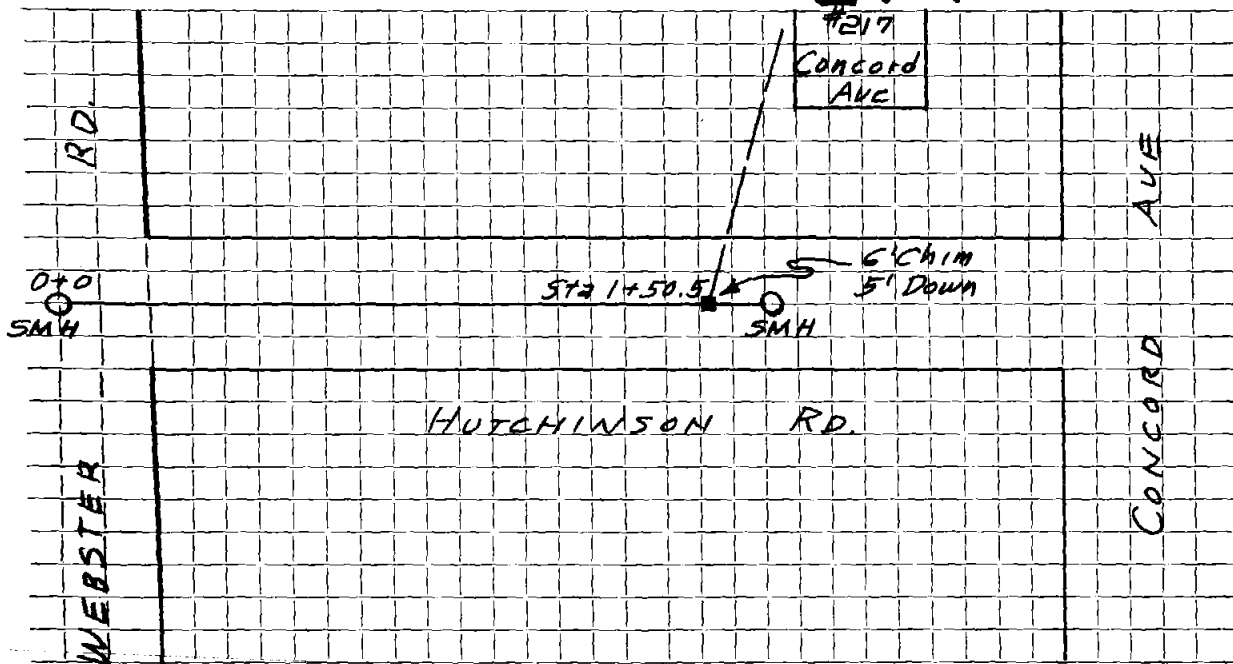

Connection made in Street. Work completed

Remarks:
.....
.....