

Name William Strong

Service No. 30

Address 225 Concord Avenue

Location

Kind of Pipe

Size

Size of Main

~~Repair Renewal~~ - New Service WD #7153

Location Comm 6-25-62


Date	Material	Amount	Total	Date	Amount
4-20-62	Labor	83.55		4-16-62	200.00
	10% O.H.	8.36	91.91	7-16-62	4.81
	80' 6" Transite pipe @.78		62.40		204.81
	1 11 <sup>1</sup> / <sub>4</sub> " Transite Bend		5.10		
	1 90° Transite Elbow		5.40		
	8 x 3 Patch		8.00		
	4 hrs. Town Shovel @6.50		26.00		
	2 hrs. Trucking @3.00		6.00		
			204.81		

DATE \_\_\_\_\_

TOWN OF LEXINGTON — BOARD OF PUBLIC WORKS  
SEWER DIVISION

Sketch of Service Here

225

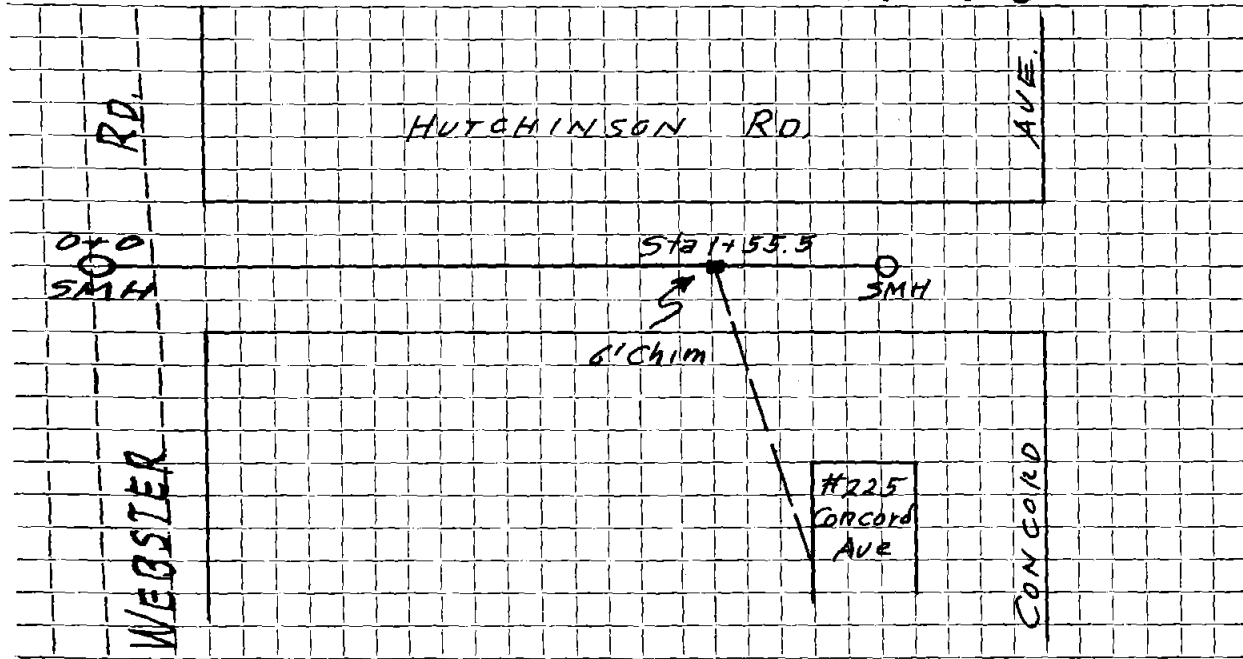

Connection made in ..... Street. Work completed .....

Remarks: .....  
.....  
.....