

Name Temple Emunha (Joel Myers)

Service No. 33 125

Address #235 Concord Avenue

Location

Kind of Pipe A.C.

Size 6"

Size of Main 8"

Repair—Renewal—New Service Valeri Const. #2636

Location AUG 16 1976

Date	Material	Amount	Total	Date	Amount
9/4/74	13' A.C.	\$7.00	\$91.00	5-7-75	Deposit 91.00
5/13/75	30' 6" Transite Pipe				
	10' 4" Cast Iron Pipe			9-4-74	
				13' 6" A.C.	


DATE _____

TOWN OF LEXINGTON — BOARD OF PUBLIC WORKS

SEWER DIVISION

Sketch of Service Here

235

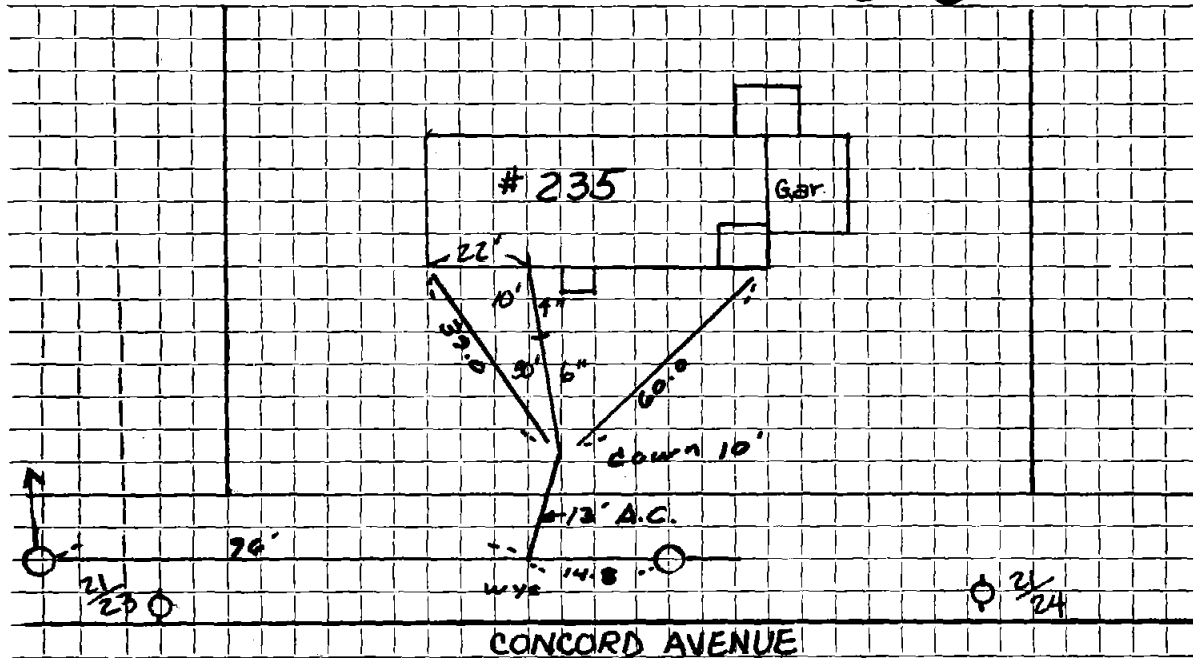

Connection made in CONCORD AVE Street. Work completed 5-13-79

Remarks: