

Name Jorge E. Rodriguez

Service No. 35

Address #239 Concord Avenue

Location

AUG 6 1979

Kind of Pipe A.C.

Size

6"

Size of Main

8"

~~Repair/Renewal~~ New Service Valeri #3234

Location

Date	Material	Amount	Total	Date	Amount
------	----------	--------	-------	------	--------

<del>9/4/74</del>	<del>15' A.C.</del>	\$ 7.00	\$ 105.00	5-31-79	Deposit	105.00
-------------------	---------------------	---------	-----------	---------	---------	--------


9-4-74

15' 6" A.C.

DATE \_\_\_\_\_

TOWN OF LEXINGTON — BOARD OF PUBLIC WORKS  
SEWER DIVISION

Sketch of Service Here **239**

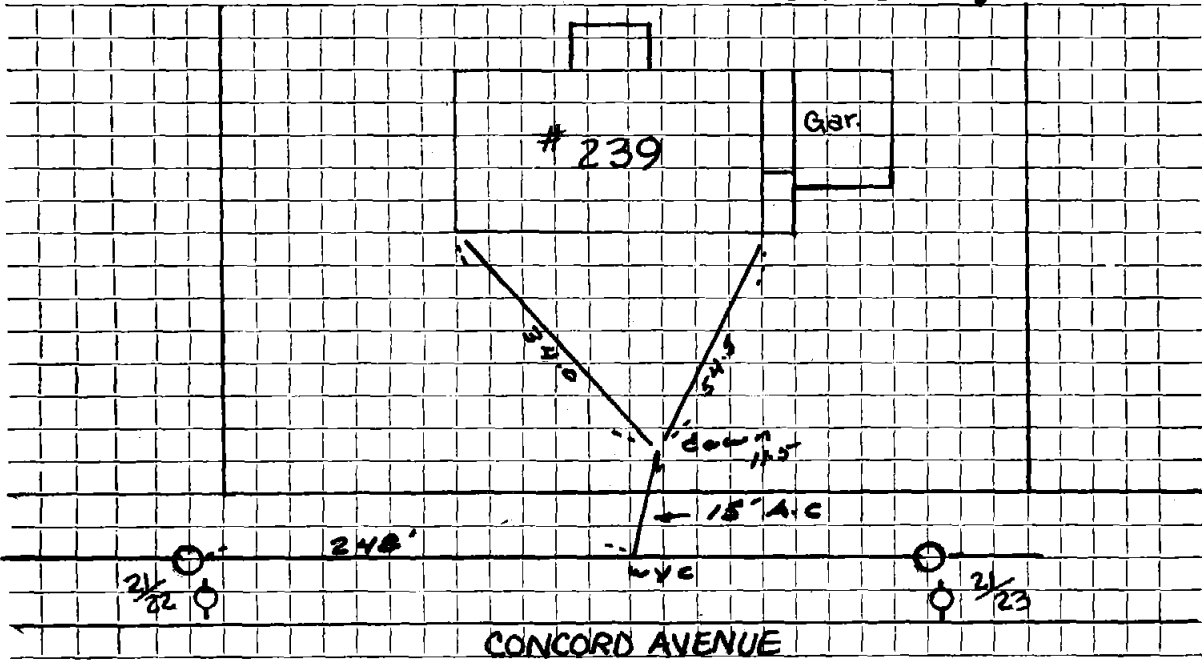

Connection made in ..... Street. Work completed .....

Remarks: .....  
.....  
.....