


DATE _____

TOWN OF LEXINGTON — BOARD OF PUBLIC WORKS

SEWER DIVISION

Sketch of Service Here

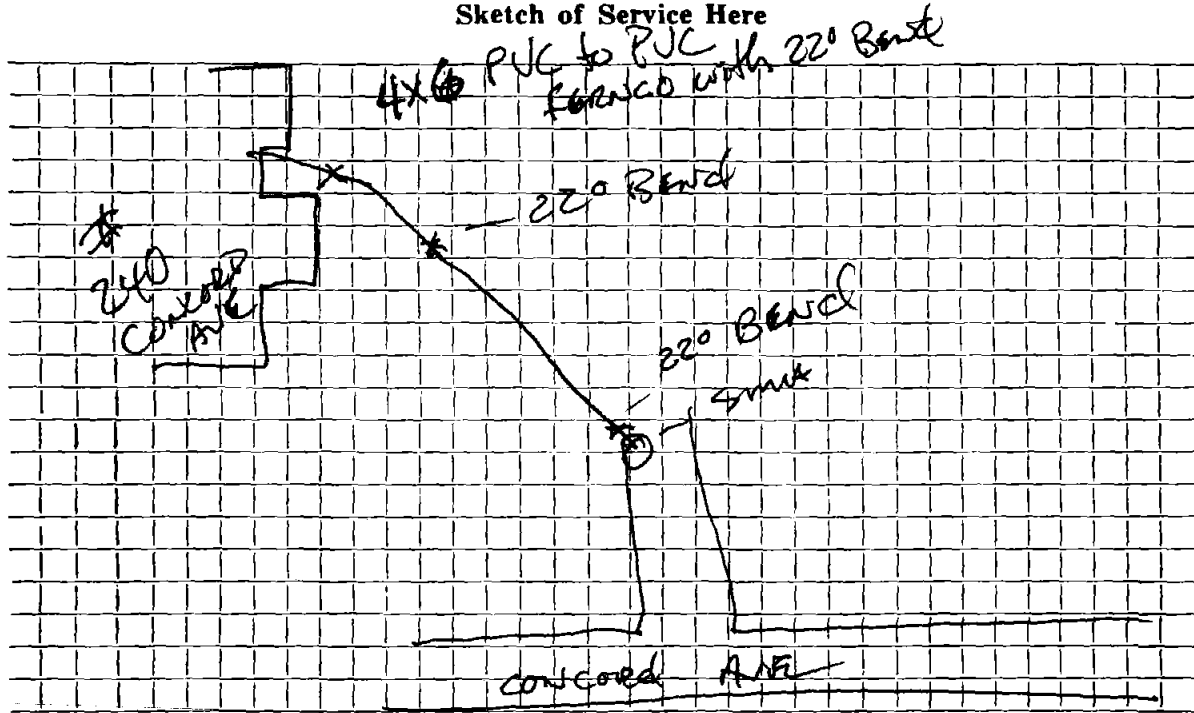

Connection made in _____ Street. Work completed _____
Remarks: SERVICE CONNECTS TO MANHOLE IN DRIVEWAY