

Name

Service No.

Address #246 CONCORD AVE

Location

Kind of Pipe

A.C.

Size

6"

Size of Main

8"

Repair—Renewal—New Service

Location

Date

Material

Amount

Total

Date

Amount

~~11/13/74~~ 32' A.C. @ \$7.00 \$224.00

11-13-74


32' 6" A.C.

DATE \_\_\_\_\_

TOWN OF LEXINGTON — BOARD OF PUBLIC WORKS  
SEWER DIVISION

Sketch of Service Here **246**

#246

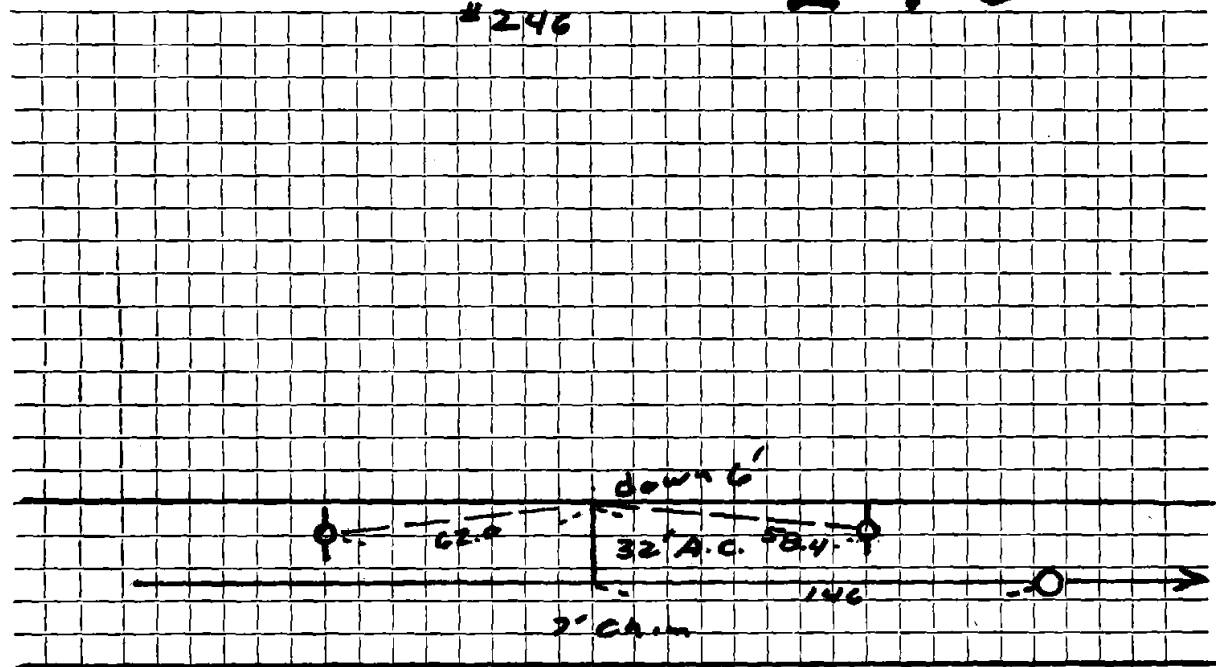

Connection made in ..... Street. Work completed .....

Remarks: .....  
.....  
.....