

Name

Service No.

Address #247 Concord Avenue

Location

Kind of Pipe A.C.

Size 6"

Size of Main 8"

Repair—Renewal—New Service

Location

Date	Material	Amount	Total	Date	Amount
------	----------	--------	-------	------	--------

~~5/4/74 12' A.C.~~

~~7.00 \$ 84.00~~


9-4-74

12' 6" A.C.

DATE _____

TOWN OF LEXINGTON — BOARD OF PUBLIC WORKS
SEWER DIVISION

Sketch of Service Here **247**

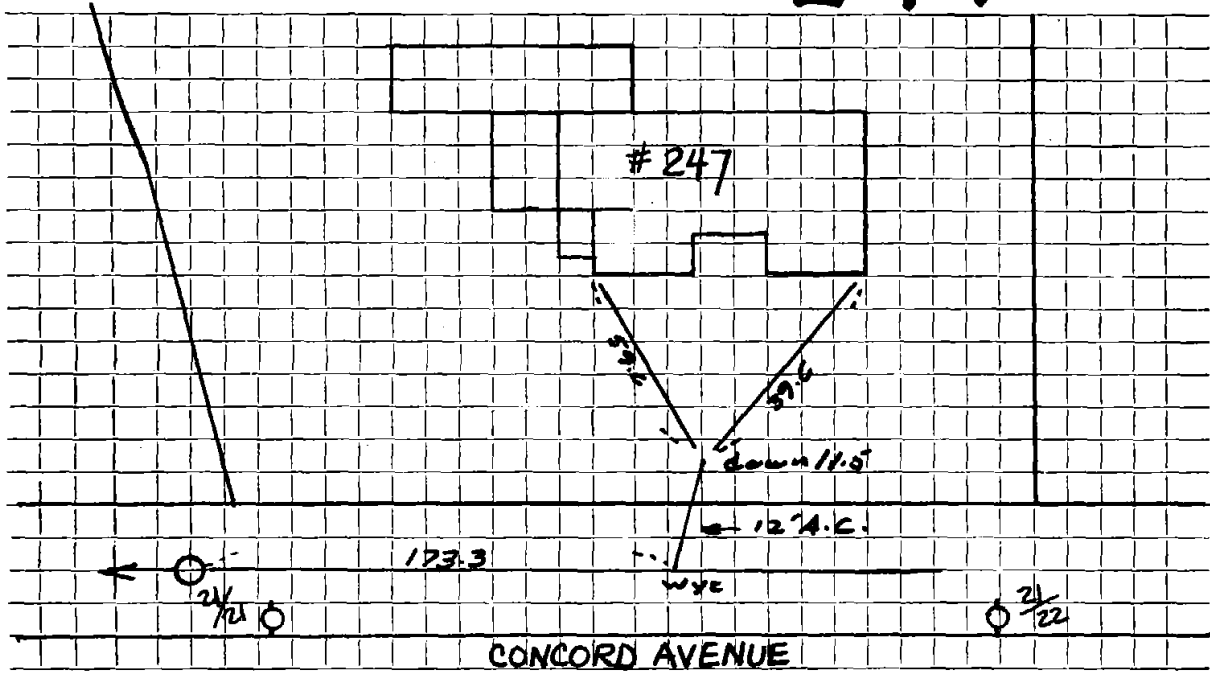

Connection made in Street. Work completed

Remarks:
.....
.....