


DATE 1/5/94

TOWN OF LEXINGTON — BOARD OF PUBLIC WORKS
SEWER DIVISION

Sketch of Service Here 253

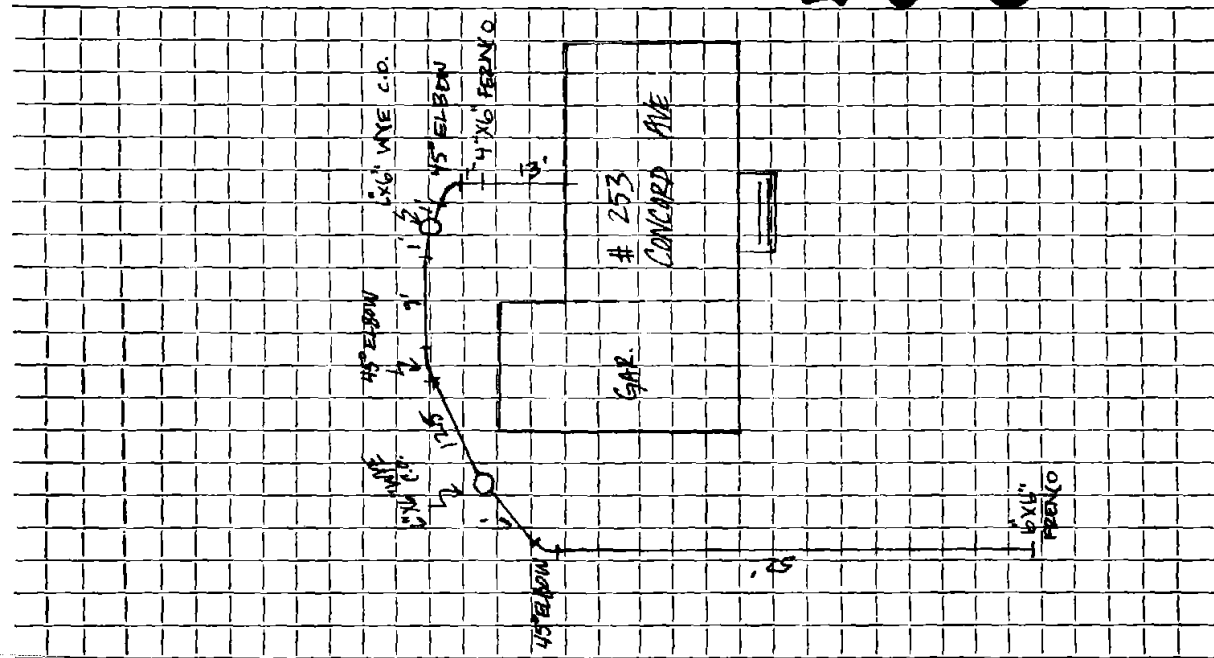

Connection made in Street. Work completed 6/24/93. KIRKLAND & SHAW

Remarks:
.....
.....