


DATE _____

TOWN OF LEXINGTON — BOARD OF PUBLIC WORKS

SEWER DIVISION

267 Sketch of Service Here

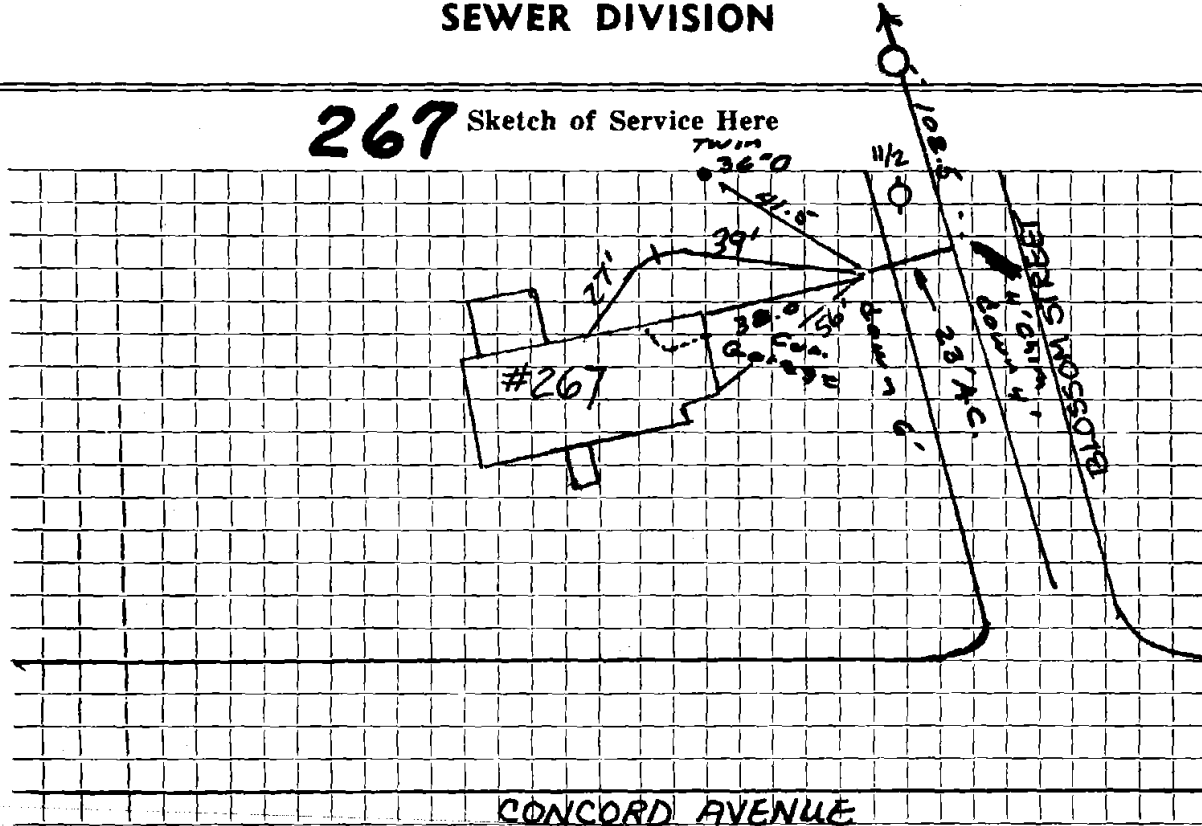

CONCORD AVENUE

Connection made in BLOSSOM Street. Work completed 6-24-75

Remarks: V.C. PIPE LEFT IN BECAUSE OF CONCRETE PATIO