


DATE _____

TOWN OF LEXINGTON — BOARD OF PUBLIC WORKS
SEWER DIVISION

275 Sketch of Service Here

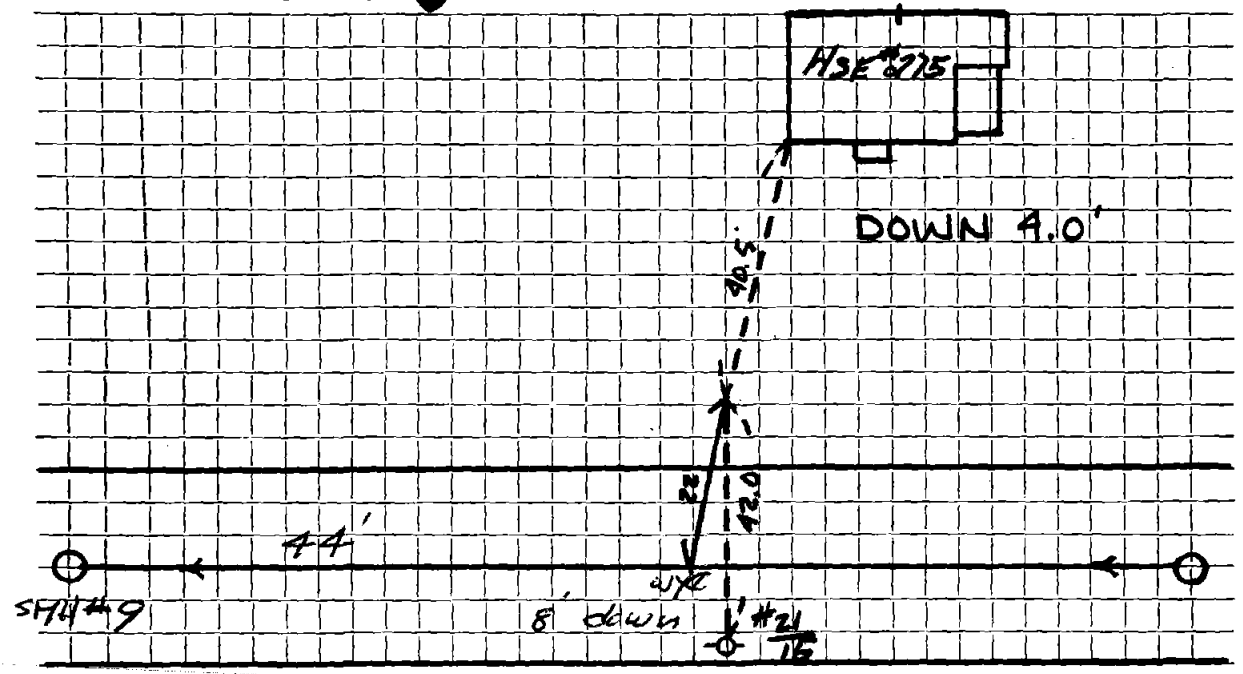

Connection made in Concord Ave. Street. Work completed

Remarks: