


DATE 9-29-76

TOWN OF LEXINGTON — BOARD OF PUBLIC WORKS

SEWER DIVISION

Sketch of Service Here **288**

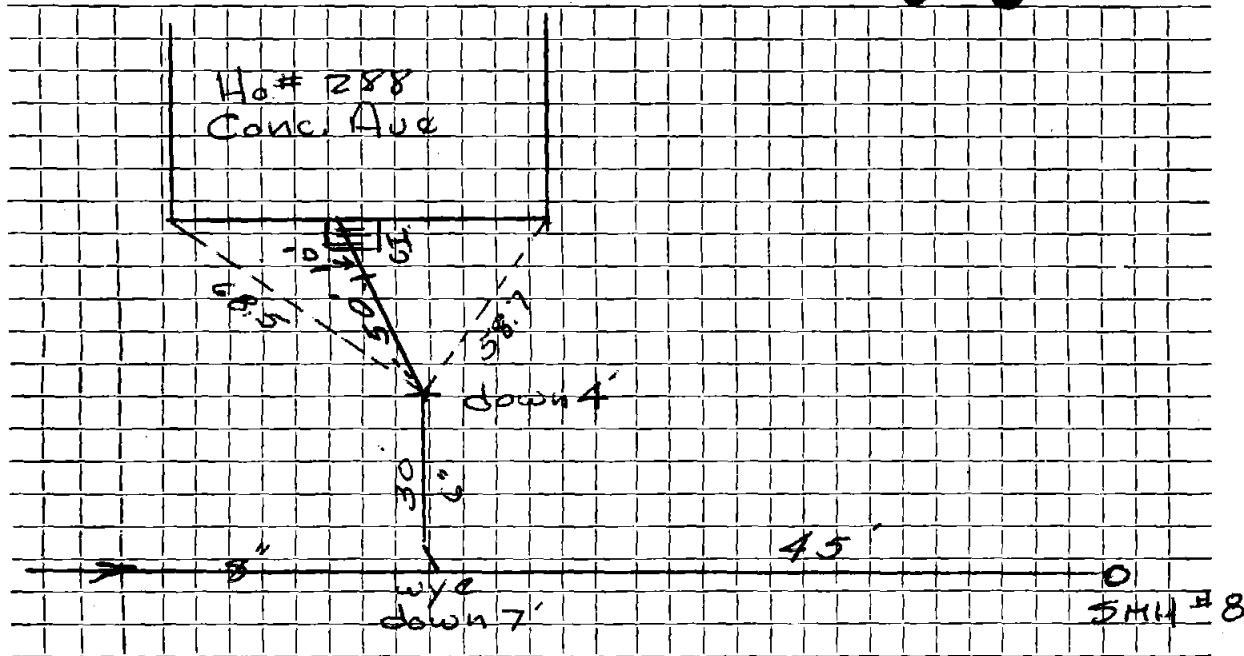

Connection made in Concord Ave. Street. Work completed

Remarks:

.....

.....