

Name James H. Cassella

Service No. 94

1974

Address # 291 Concord Ave

JUN 20 1977

Location

Kind of Pipe

Size 6'

Size of Main 8'

~~Renewal~~ New Service Valeri #2882

Location

Date	Material	Amount	Total	Date	Amount
------	----------	--------	-------	------	--------


7-12-70	20' 6" AC @	10.00 =	# 260.00	10/25/70	Deposit	260.00	-
Nov. 76	100' = 6" A.C.P.						
	27' = 4" C.I.			7-12-76			
				26'	6" A.C.		

DATE _____

TOWN OF LEXINGTON — BOARD OF PUBLIC WORKS
SEWER DIVISION

Sketch of Service Here

291

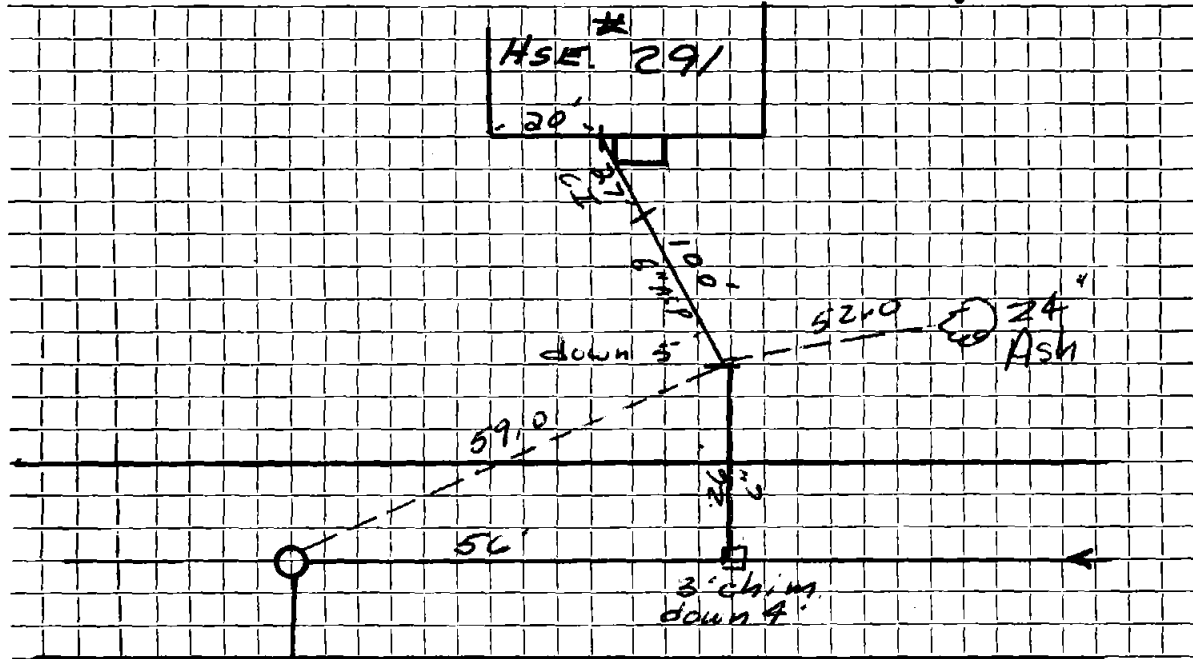

Connection made in Concord Ave. Street. Work completed

Remarks: