


DATE _____

TOWN OF LEXINGTON — BOARD OF PUBLIC WORKS

SEWER DIVISION

Sketch of Service Here

303

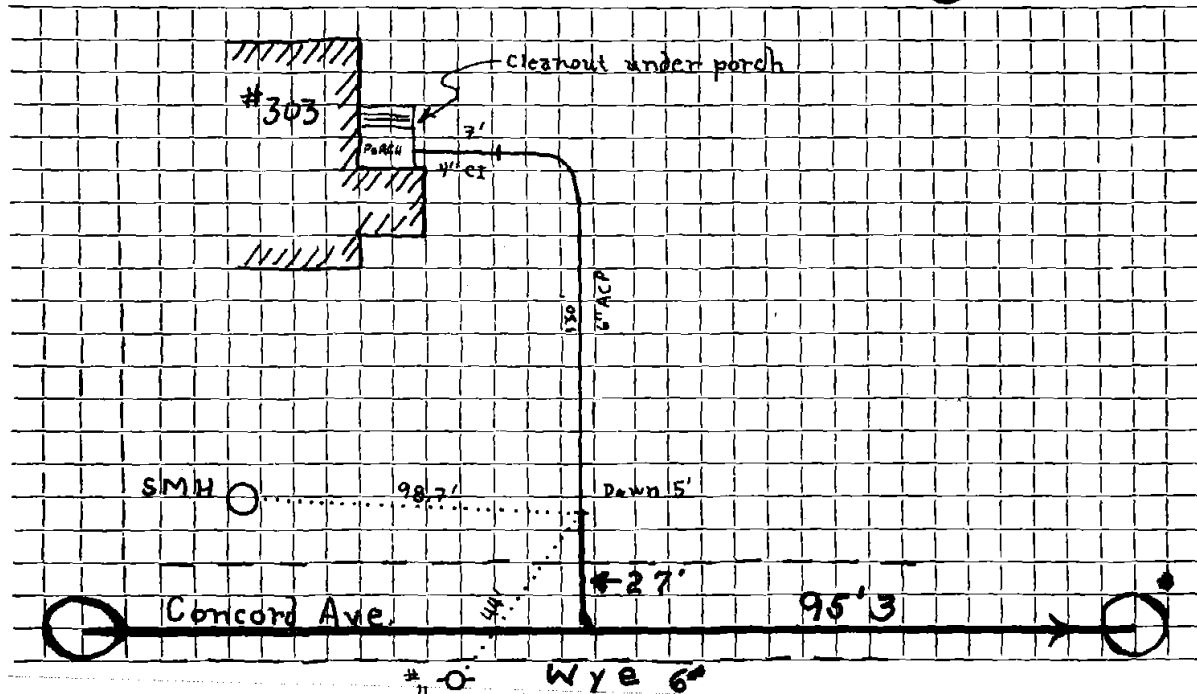

Connection made in Street Down. Work completed

Remarks:

.....

.....