

Name Raymond J. Flynn

Service No. 49

Address 310 Concord Avenue

Location

Kind of Pipe Size Size of Main

~~REPAIR~~ New Service Valeri #3599


Location OCT 6 1980

Date		Material	Amount	Total	Date		Amount
7-19-76	21'	6" Transite Pipe @	10.00	210.00	9-18-80	Deposit	210.00
9-22-80	101'	6" Transite pipe					
	6	10' x 6" Transite pipe					
	7	5' x 6" Transite pipe					
	1	22° x 6" Sweep					
	1	30° x 6" Sweep					
	1	2' x 6" Nipple					

DATE \_\_\_\_\_

TOWN OF LEXINGTON — BOARD OF PUBLIC WORKS  
SEWER DIVISION

Sketch of Service Here **310**

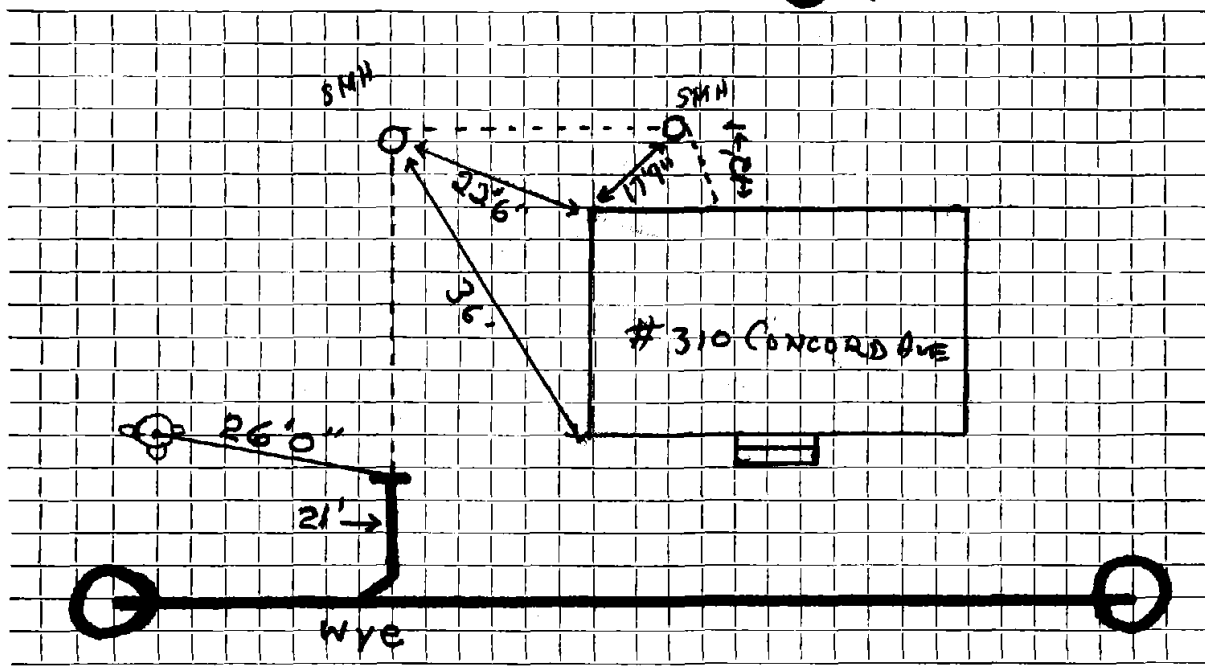

Connection made in ..... Street. Work completed .....

Remarks: .....  
.....  
.....