


DATE _____

TOWN OF LEXINGTON — BOARD OF PUBLIC WORKS

~~WATER~~ DIVISION
SEWER

Sketch of Service Here

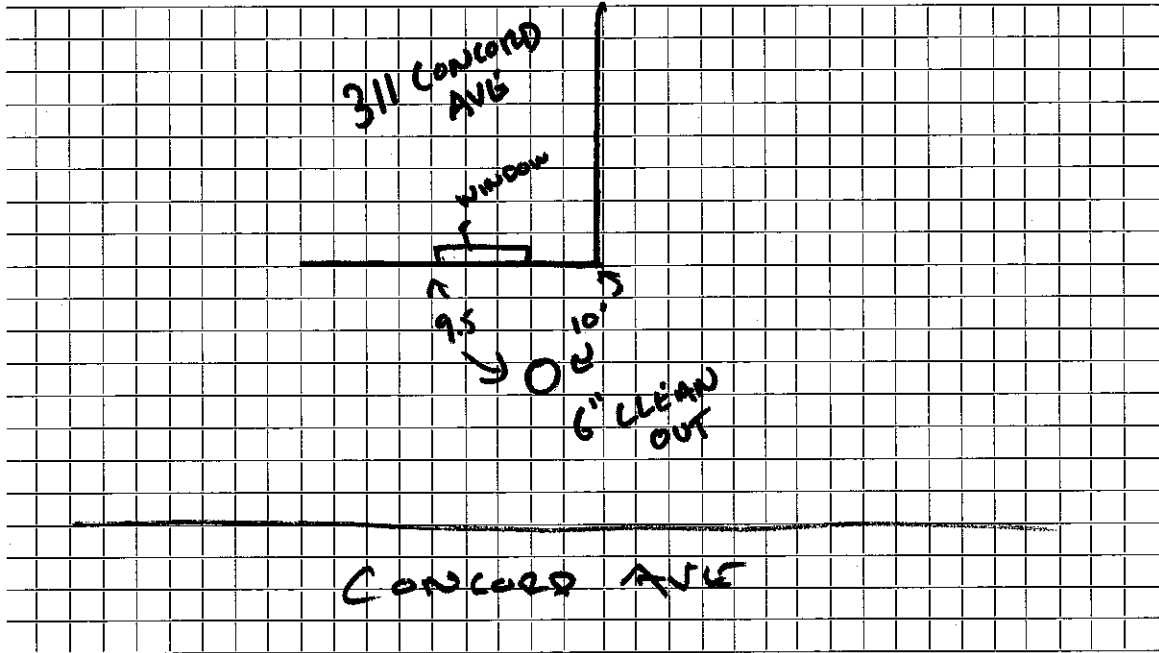

Connection made in CONCORD Street. Work completed FROTTON

Remarks:

.....

.....