


DATE 9-28-76

TOWN OF LEXINGTON — BOARD OF PUBLIC WORKS
SEWER DIVISION

Sketch of Service Here **314**

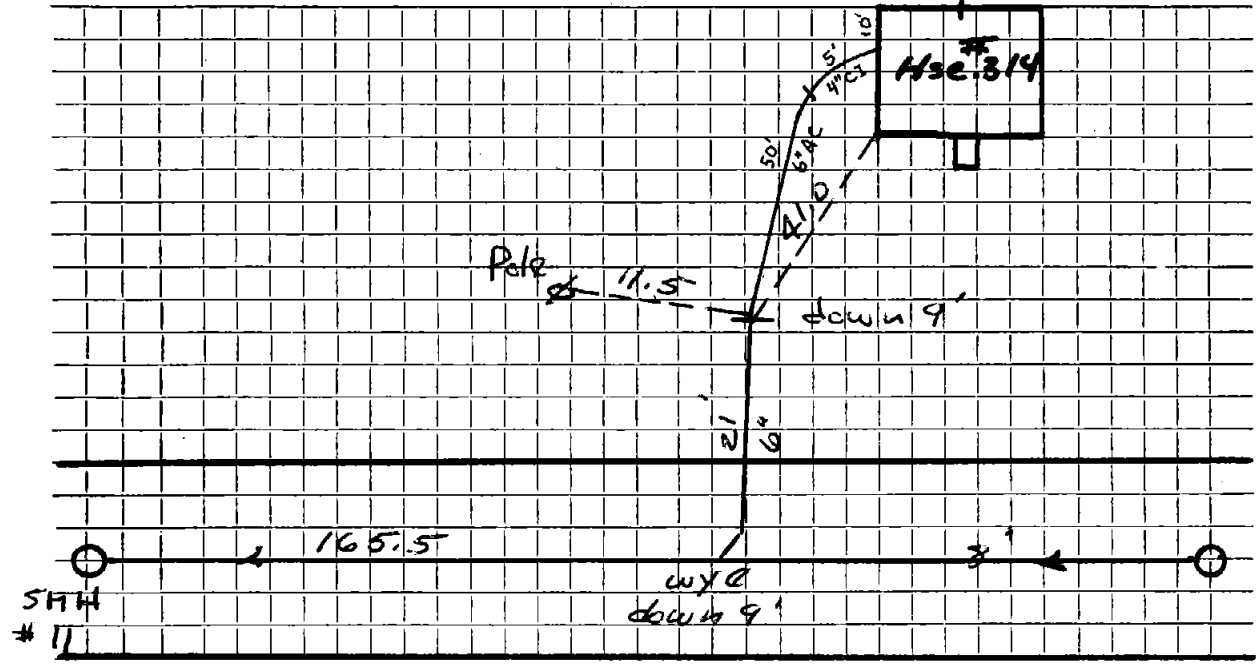

Connection made in Concord Ave. Street. Work completed

Remarks:
.....
.....