

Name Michael N. Megliola

Service No. 88

Address # 320 CONCORD AVE

Location

Kind of Pipe

Size 6"

Size of Main 8"


Repwork ~~Renwork~~ - New Service Valeri #3356

Location DEC 26 1978

Date	Material	Amount	Total	Date	Amount
7-20-76	23' 6" AC @	10.00 =	\$ 230.00	11-9-78	230.00
11/8/78	52' 6" Transite Pipe				
	5' 4" Cast Iron Pipe			7-20-76	
				23' 6" A.C.	

DATE 9-28-76

TOWN OF LEXINGTON — BOARD OF PUBLIC WORKS
SEWER DIVISION

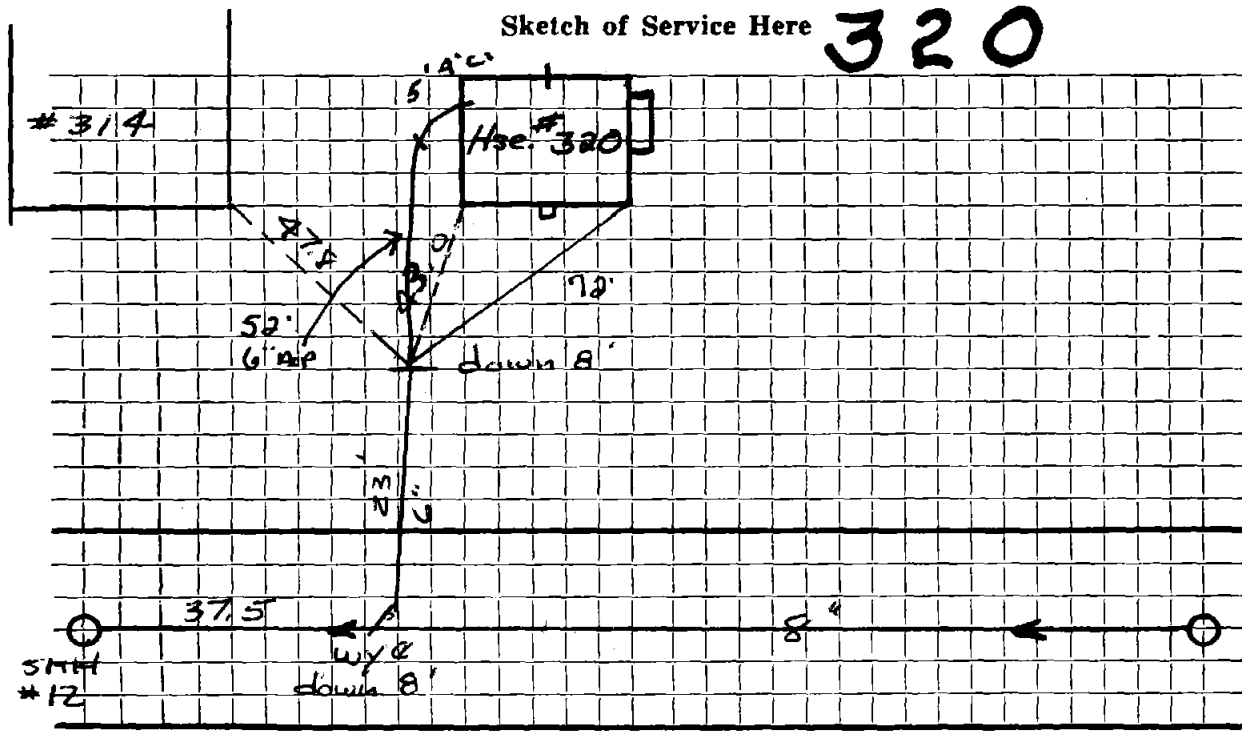

Connection made in Concord Ave. Street. Work completed

Remarks:

.....

.....