

Name David Turnquist

Service No. 456

Address 321 CONCORD AVE.

Location

Kind of Pipe CI & PVC

Size 4" & 6"

Size of Main 8"

~~McLaughlin~~ New Service #4972 McLaughlin

Location


Date		Material	Amount	Total	Date		Amount
4/22/88		3 LF 4" CI			4-22-88	Deposit	290 00
		12 LF 4" PVC					
		23 LF 6" PVC			7-14-76		
		4" CI CLEANOUT			29'	6" A.C. + C.I.	
		4' x 6" FERNCO					
		6" x 6" FERNCO					
		45° 4" ELBOW					
7-14-76	29'	6" AC & CI @	\$10.00	\$290 00			

DATE 6/9/88

TOWN OF LEXINGTON — BOARD OF PUBLIC WORKS
SEWER DIVISION

Sketch of Service Here

321

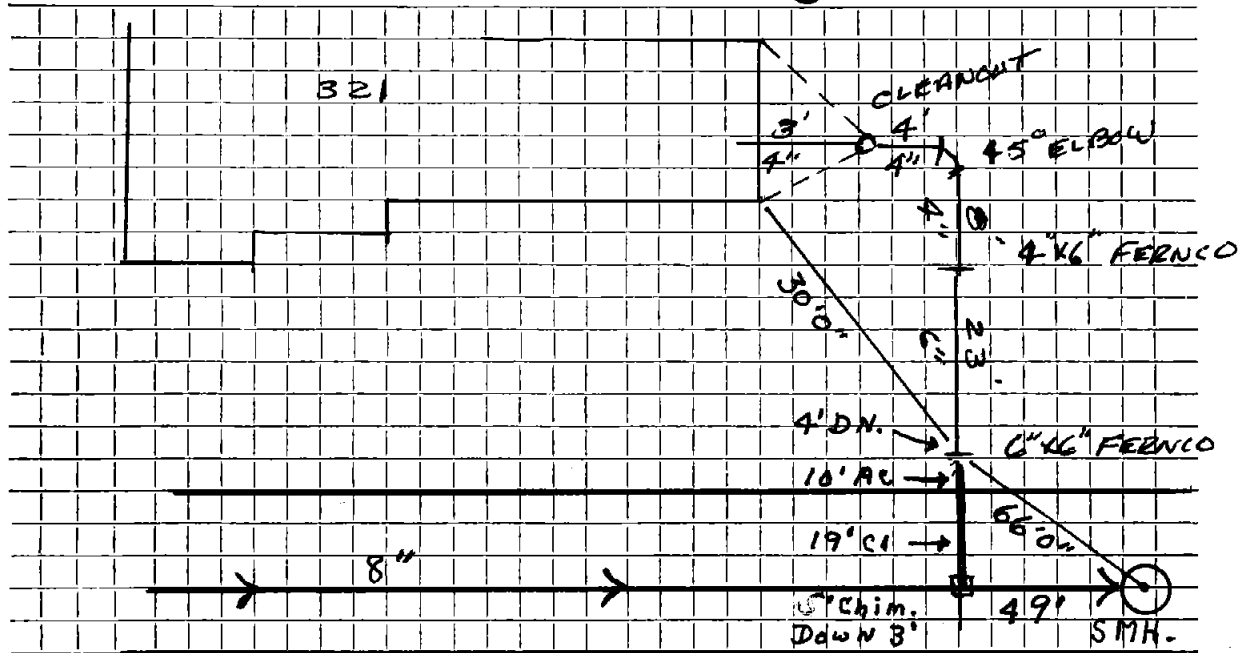

Connection made in CONCORD AVE Street. Work completed

Remarks: 19' C.I. + 10' A.C.