




DATE \_\_\_\_\_

TOWN OF LEXINGTON — BOARD OF PUBLIC WORKS  
SEWER DIVISION

Sketch of Service Here **324**

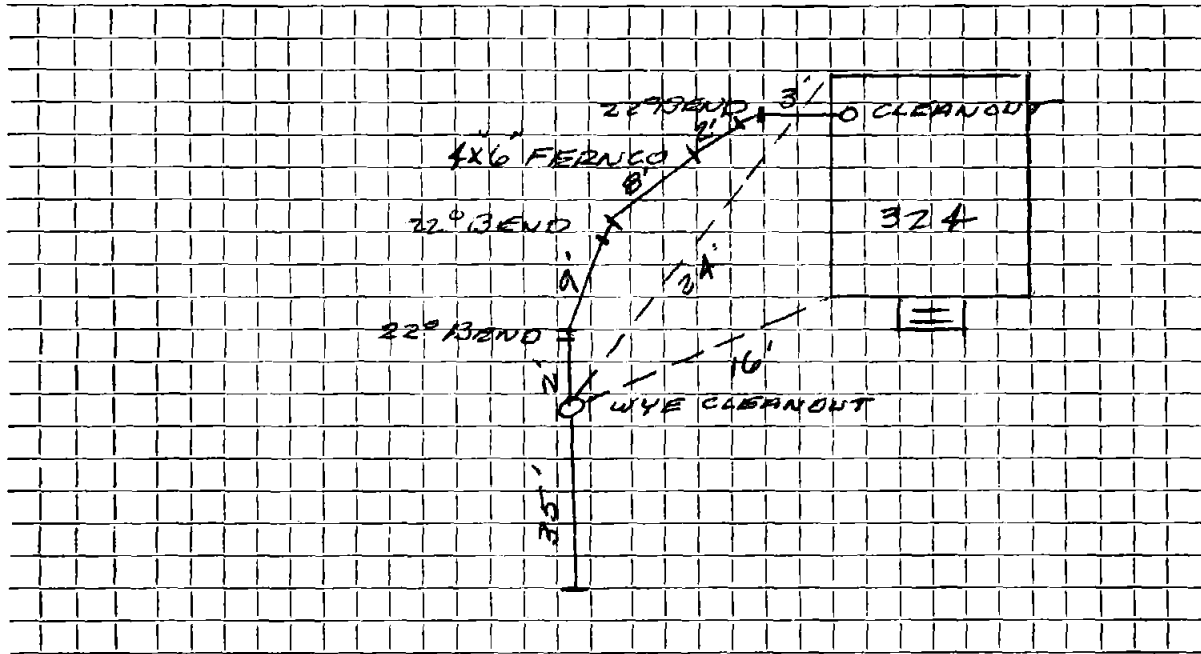

Connection made in CONCORD AVE. Street. Work completed .....

Remarks: CLEANOUT IN DRY.  
.....  
.....