

Name Louis Cannizzo

Service No. 46

Address # 331 + 329 CONCORD AVE.

Location

AUG 29 1977

Kind of Pipe AC

Size C'

Size of Main 8"

Repair—Renewal—New Service Lucente #3170

Location


Date		Material	Amount		Total	Date		Amount
7-21	76	28' 6" AC	10.00	=	280.00	7-13-77	<u>Deposit</u>	<u>280.00</u>
7/14/77	25'	6" transite pipe						
	10'	4" cast iron pipe				7-21-76		
						28'	6" A.C.	

DATE 9-28-76

TOWN OF LEXINGTON — BOARD OF PUBLIC WORKS
SEWER DIVISION

Sketch of Service Here

329

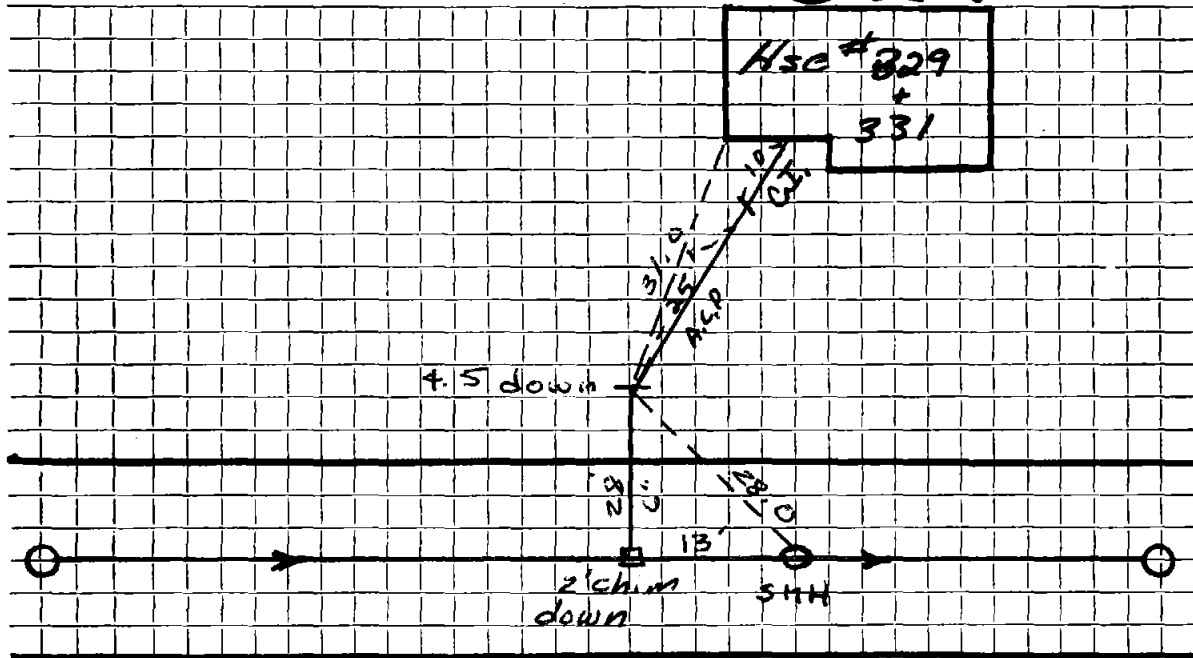

Connection made in Concord Ave. Street. Work completed

Remarks:

.....
.....