

Name

Service No.

Address 332 Concord Ave.

Location

Kind of Pipe AC

Size 6"

Size of Main 8"

Repair—Renewal—New Service


Location

Date	Material	Amount	Total	Date	Amount
7-21-76	26' 6" AC @	10.00	= \$ 260.00	7-21-76	26' 6" A.C.

DATE 9-29-76

TOWN OF LEXINGTON — BOARD OF PUBLIC WORKS
SEWER DIVISION

Sketch of Service Here

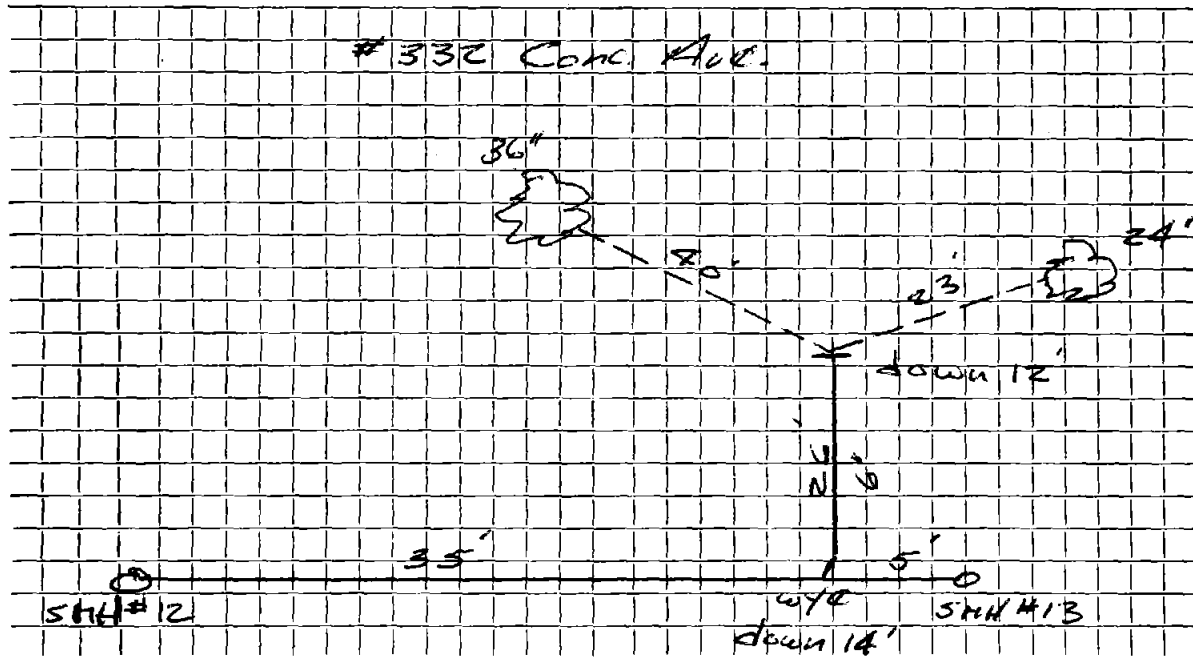

Connection made in Concord Ave Street. Work completed

Remarks:

.....

.....