

Name

Service No. 2054

Address 334 Concord AVE

Location

Kind of Pipe PVC

Size 6"

Size of Main 8"

Repair—Renewal—New Service T. D. John Litchfield

Location


| Date | Material | Amount | Total | Date | Amount |
|-----------|--|--------|-------|------|--------|
| 3/29/06 | 6' 4" sec 40 | | | | |
| | 56' 6" PVC | | | | |
| | 6" Wye | | | | |
| | 4x6 Fernco | | | | |
| | 6" Clean out 1.0 From Foundation AT Grade | | | | |
| | 1 6"x6" PVC x PVC Fernco | | | | |
| 8/11/76 | 25' AC A.C. | | | | |
| " | 1 8x6 service saddle down 8' | | | | |
| 7/20/2000 | 5' PVC | | | | |
| | 1 AC x PVC Fernco | | | | |

DATE _____

TOWN OF LEXINGTON — BOARD OF PUBLIC WORKS

SEWER DIVISION

Sketch of Service Here

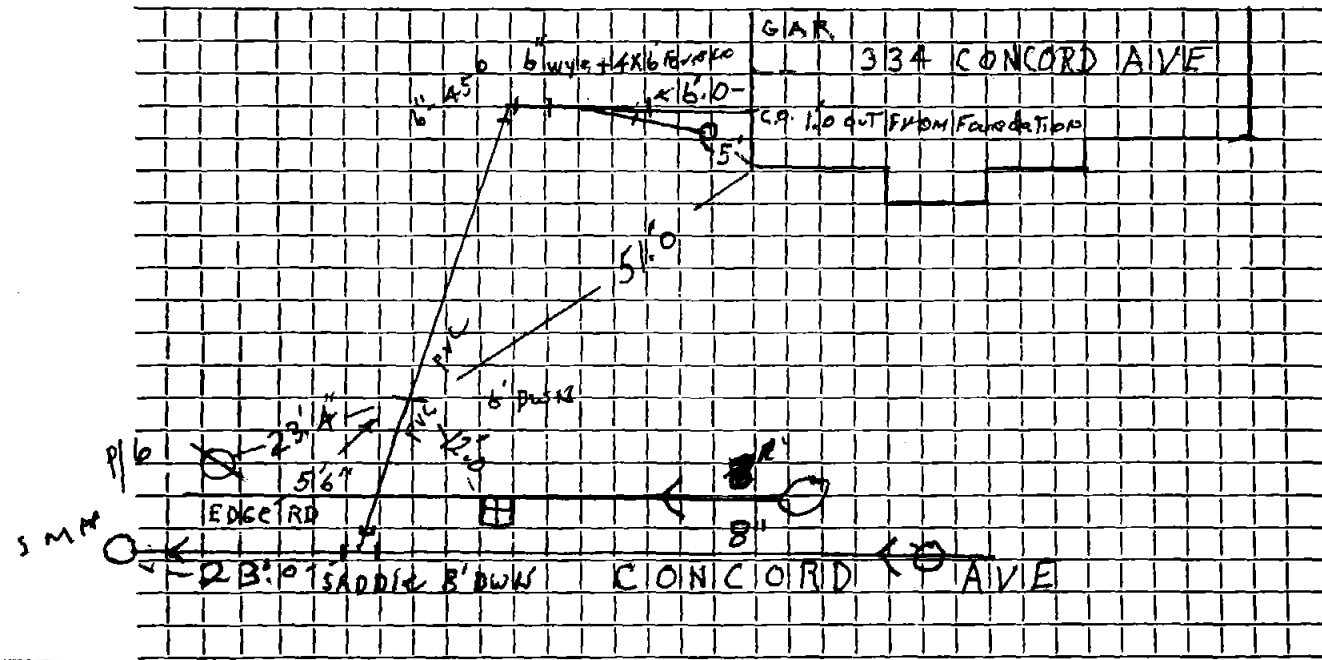

Connection made in Street. Work completed 3/29/06 John L. Feldfield.....

Remarks: P.V.C. - 1 1/2" S.T......

.....

.....