

Name

Service No.

Address 346 CONCORD AVE

Location

Kind of Pipe

SDR35

Size

6" PVC

Size of Main

Repair

~~Renewal~~

New Service

Location

Date

Material

Amount

Total

Date

Amount

6" SDR

6" CLEAN OUT

3

6" PULTRAP

6" SDR RIDER

6" WPE 1/4"


45" PVC BEND

2

TOWN OF LEXINGTON — BOARD OF PUBLIC WORKS

SEWER DIVISION

Sketch of Service Here

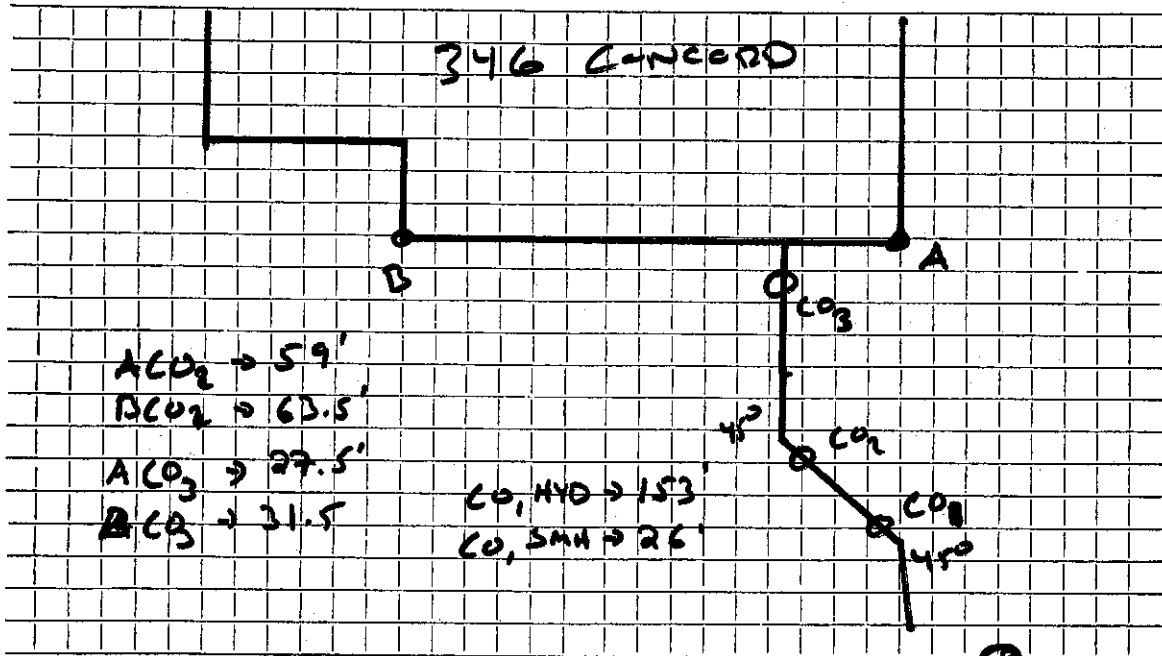

Connection made in CONCORD Street. Work completed

Remarks:

.....

.....