


DATE 12/5/89

TOWN OF LEXINGTON — BOARD OF PUBLIC WORKS
SEWER DIVISION

Sketch of Service Here **353**

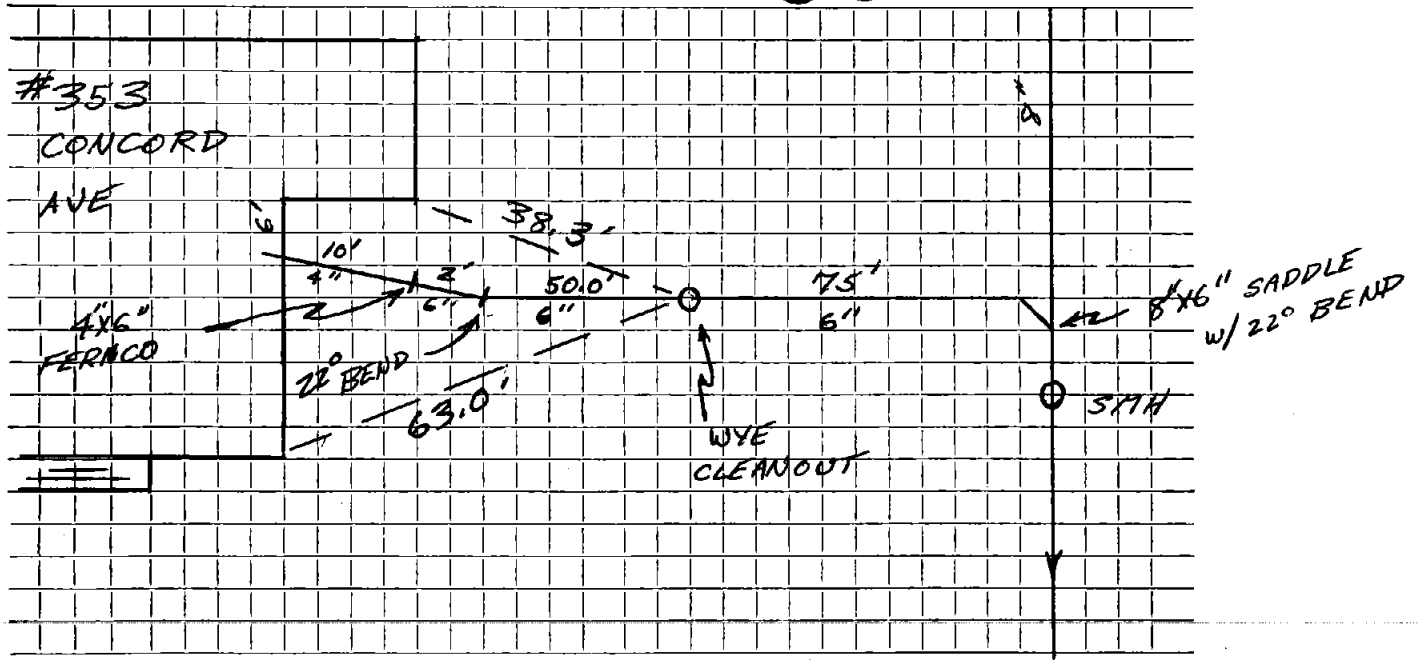

Connection made in SEWER EASEMENT Street. Work completed

Remarks: INSP. CRG Original Service 4-1-77