




6-24-97  
J. McLaughlin?

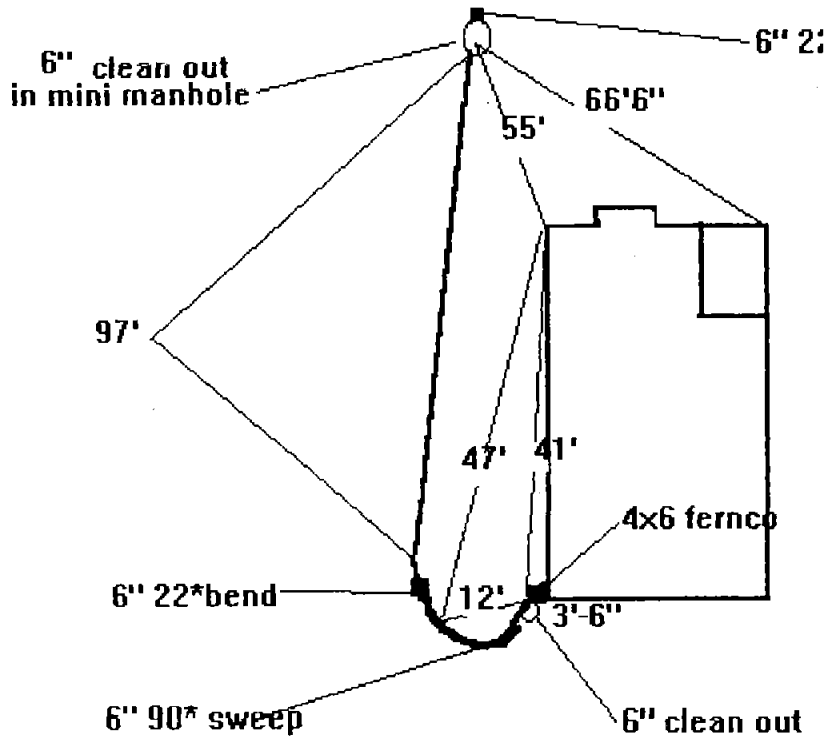


SEWER TIES  
354 CONCORD AVE

DATE \_\_\_\_\_

**TOWN OF LEXINGTON — BOARD OF PUBLIC WORKS**  
**SEWER DIVISION**

Sketch of Service Here

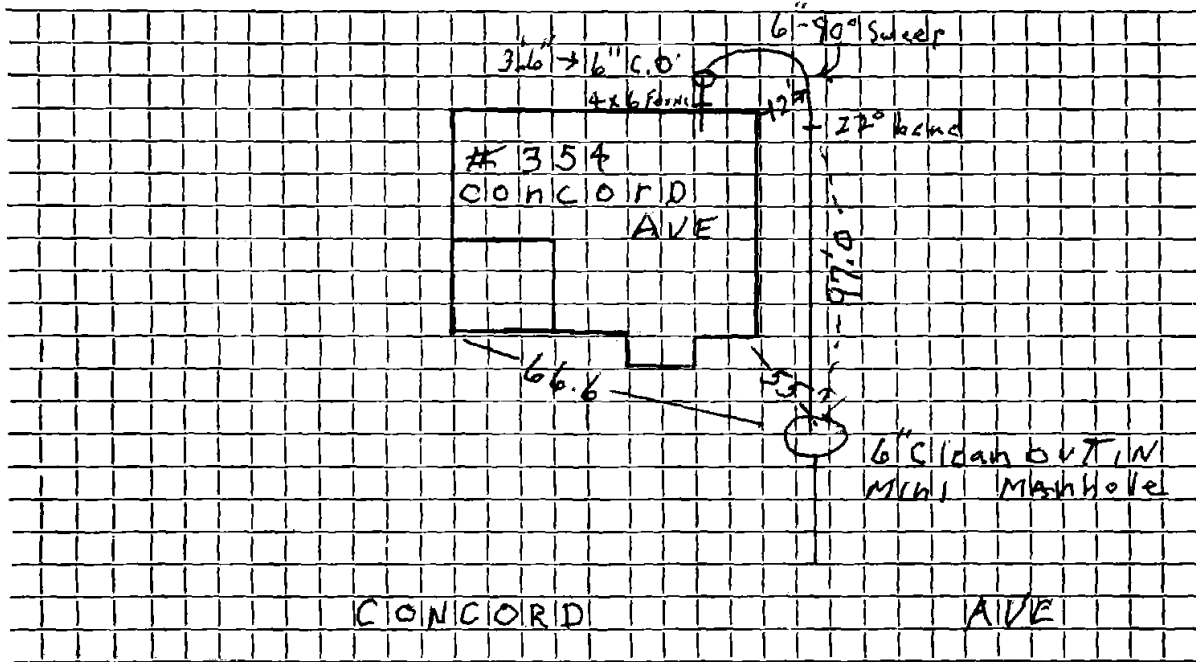

Connection made in ..... Street. Work completed 6/7/97 J. McLaughlin.....

Remarks: WAS 950 Waltham ST.....