


DATE 5 NOVEMBER 1993

TOWN OF LEXINGTON — BOARD OF PUBLIC WORKS
SEWER DIVISION

Sketch of Service Here **365-367**

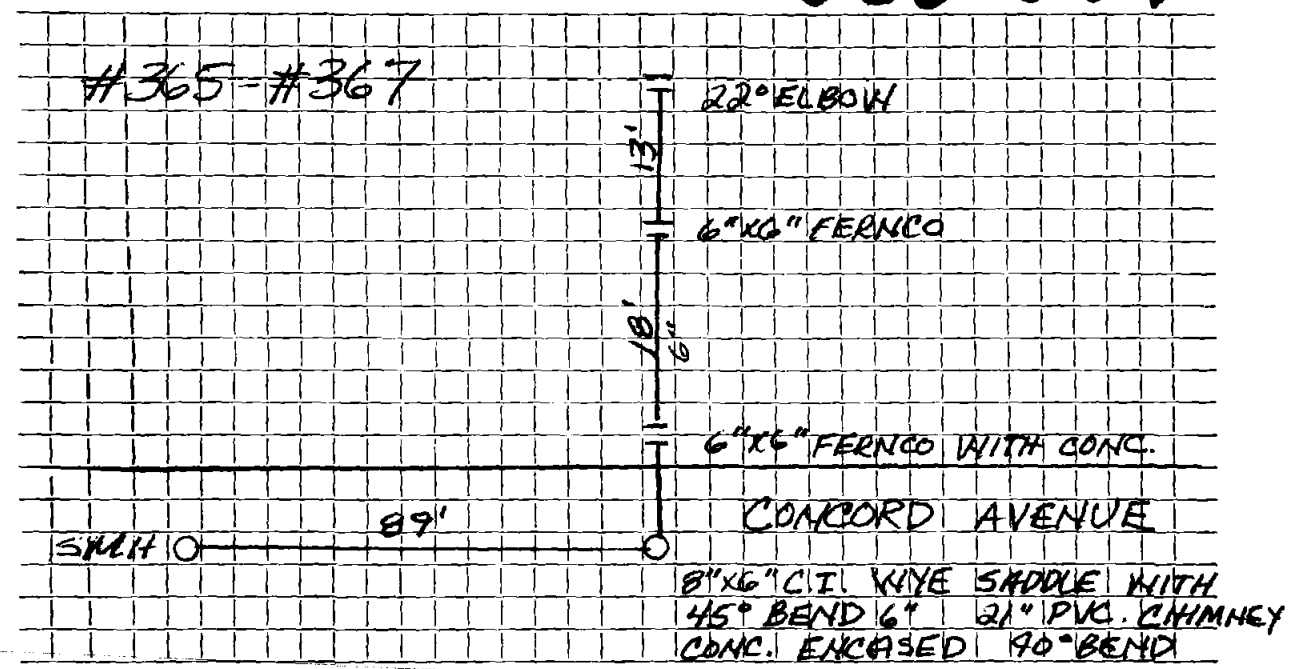

Connection made in CONCORD AVENUE Street.

Work completed J. McLaughlin

Remarks:

BOOK 96A

J.W.