

Name Gary W. Silva

Service No. 63

Address 382 Concord Ave.
Lot A

Location

Kind of Pipe

Size

Size of Main

Repair—Renewal—New Service Lexington Sewerage #2060

Location JUN 5 1972


Date	Material	Amount	Total	Date	Amount	
1971	26.5' 6" transite pipe	@12.00	318.00	5-5-72	Deposit	318.00
5-10-72	58' 6" Transite pipe			'71		
	10' 4" Cast Iron pipe			25.5'	6" Transite	

DATE _____

TOWN OF LEXINGTON — BOARD OF PUBLIC WORKS

SEWER DIVISION

Sketch of Service Here **382**

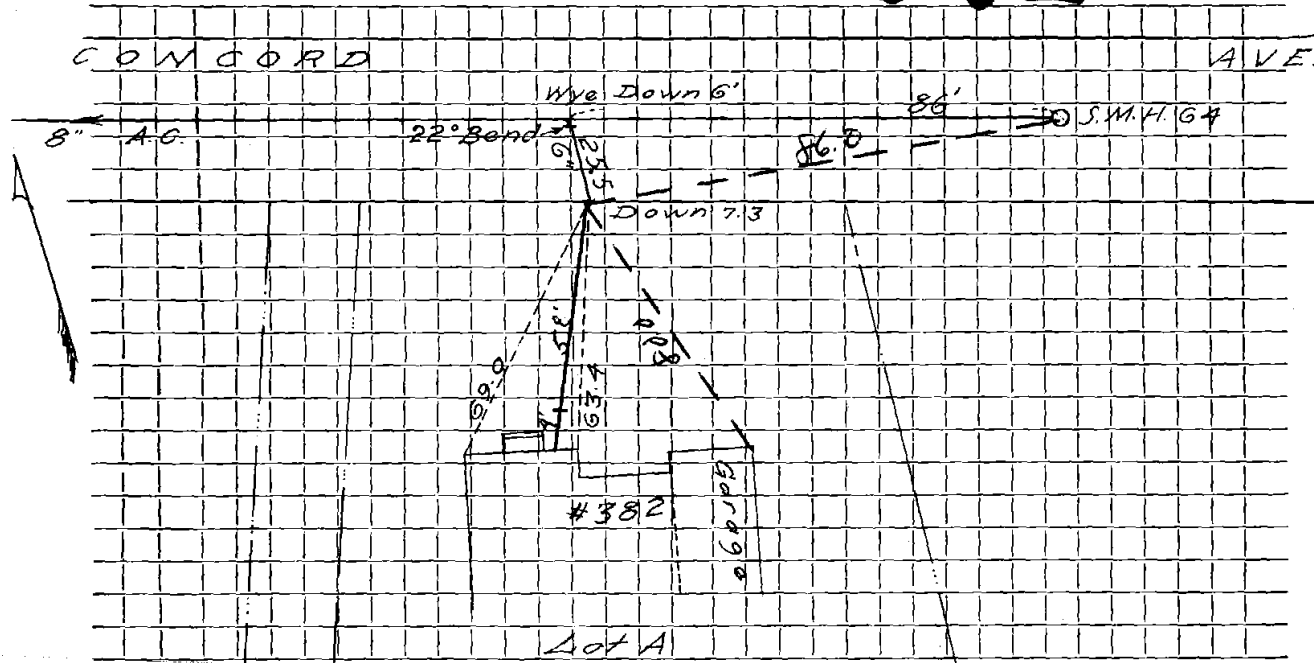

Connection made in Street. Work completed

Remarks:
.....
.....