






DATE \_\_\_\_\_

TOWN OF LEXINGTON — BOARD OF PUBLIC WORKS  
SEWER DIVISION

Sketch of Service Here

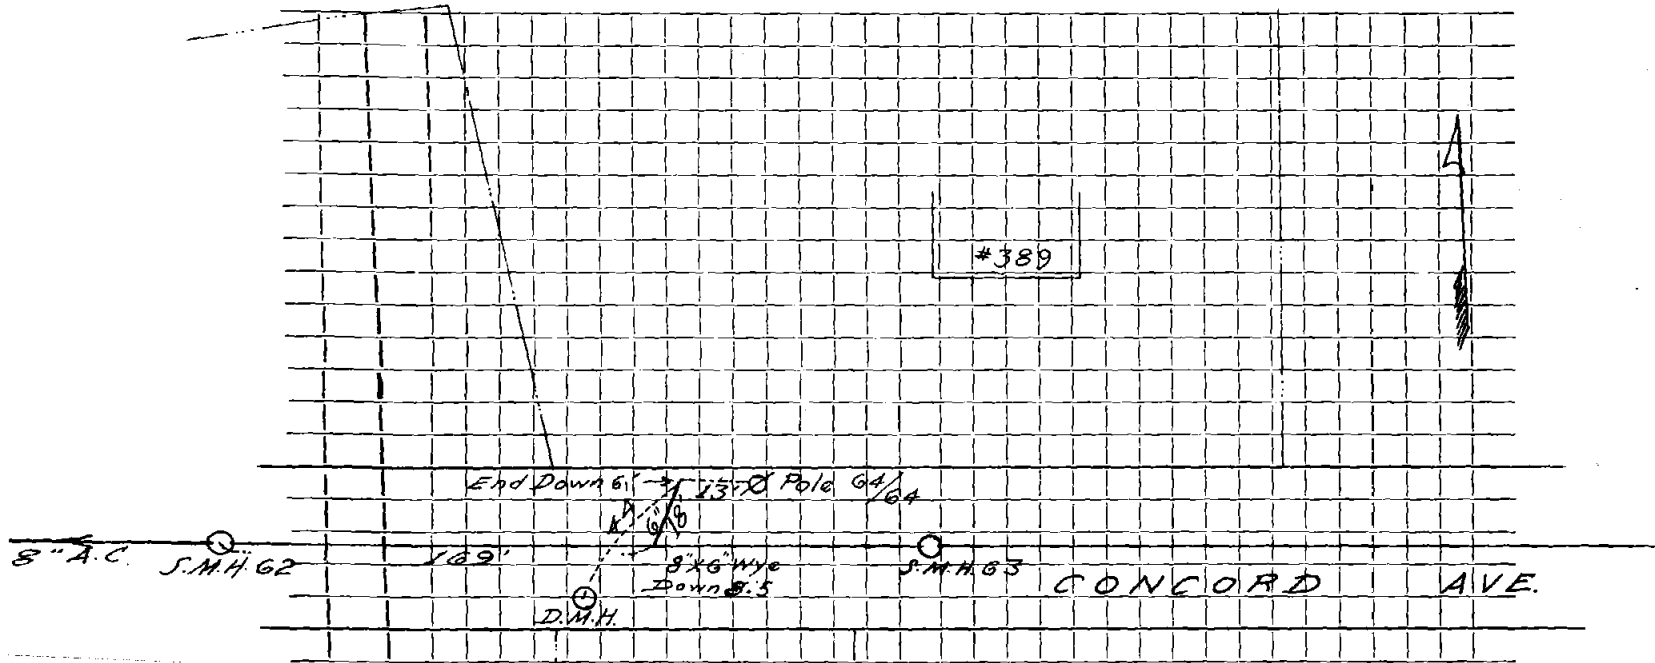

Connection made in . . . . . Street. . . . . Work completed . . . . .

Remarks: . . . . .

. . . . .


. . . . .

DATE \_\_\_\_\_

TOWN OF LEXINGTON — BOARD OF PUBLIC WORKS  
SEWER DIVISION

Sketch of Service Here

389

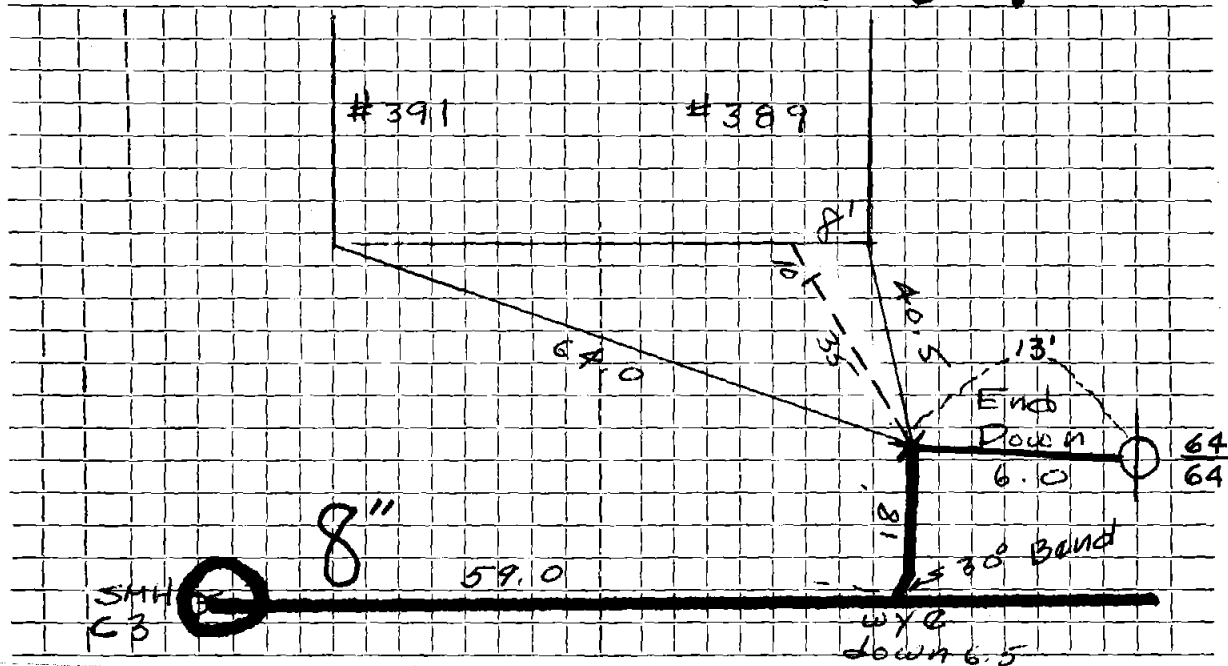

Connection made in ..... Street. Work completed .....

Remarks: .....  
.....  
.....