

Name *Irwin Spivak*

Service No.

Address *396 Concord Ave.*

Lot Assessors Map 10 Lot 12 A

Location

Kind of Pipe

Size

Size of Main

Repair—Renewal—New Service *Valeri #0612*

Location


Date		Material	Amount	Total	Date		Amount
1971	29.8'	6" transite pipe @	12.00	357.60	<i>4-21-92</i>	<i>Laid</i>	<i>357 60</i>
<i>4-27-92</i>		<i>64 LF 6" PVC</i>					
		<i>4 LF 4" PVC</i>					
		<i>6" WYE C.O.</i>					

DATE _____

TOWN OF LEXINGTON — BOARD OF PUBLIC WORKS

SEWER DIVISION

Sketch of Service Here

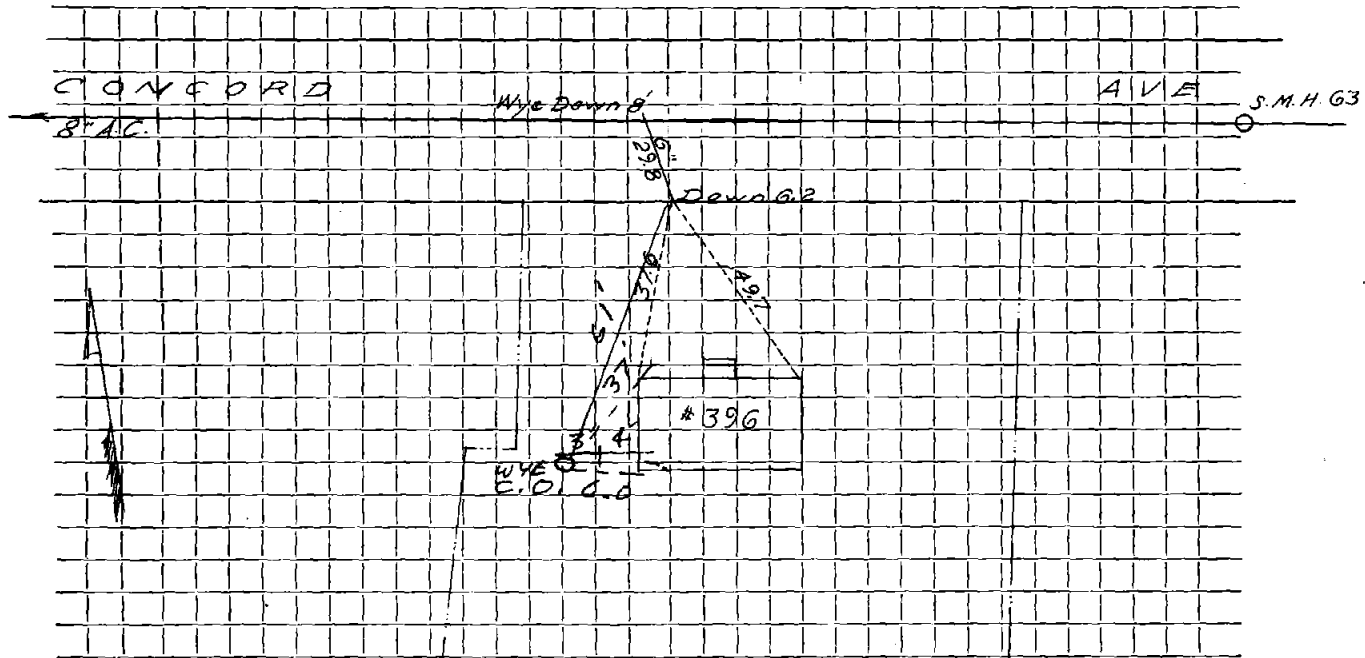

Connection made in CONCORD AVE. Street. Work completed

Remarks: VALERI

Lot Assessor's Map 10-Lot 12A