

Name

Service No.

Address 396 CONCORD AVE.

Location

Kind of Pipe PVC

Size 4" $\frac{1}{2}$ " 6"

Size of Main 8"

Repair—Renewal—New Service

Location

Date	Material	Amount		Total	Date		Amount
------	----------	--------	--	-------	------	--	--------

4/27/92

4 LF 4" PVC

64 LF 6" PVC

6" WYE C.O.


1971

29.8 6" Transite

DATE _____

TOWN OF LEXINGTON — BOARD OF PUBLIC WORKS
SEWER DIVISION

Sketch of Service Here **396**

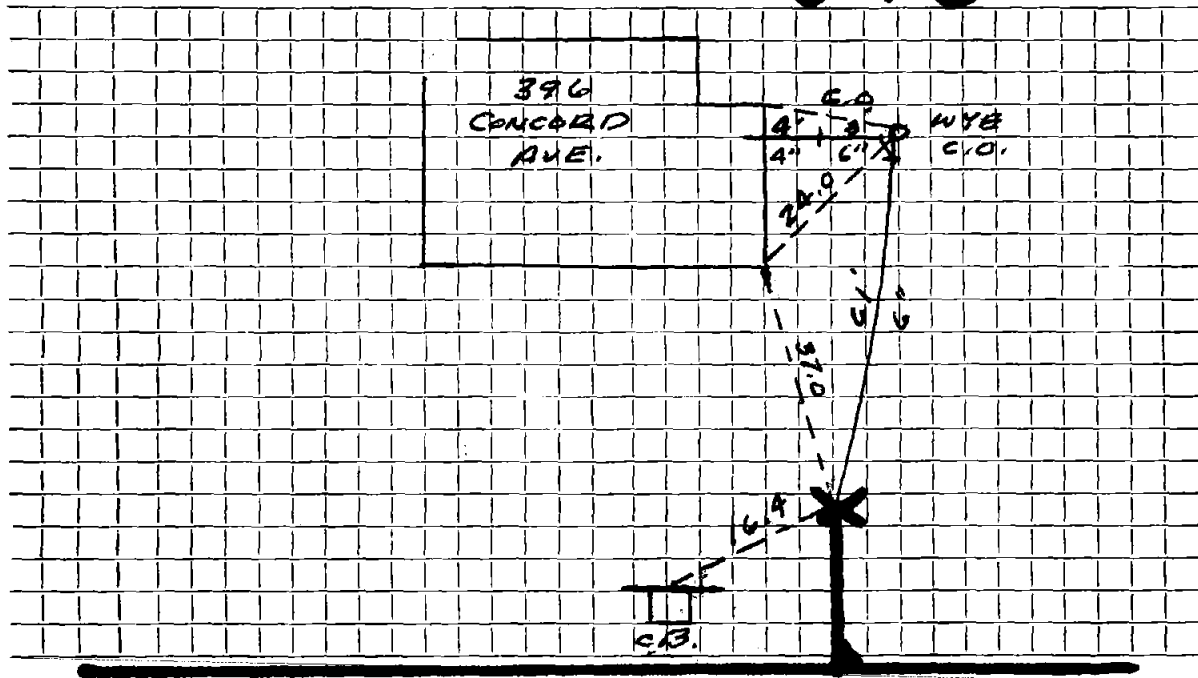

Connection made in CONCORD AVE. Street. Work completed

Remarks: VALENTI

.....
.....