


DATE _____

TOWN OF LEXINGTON — BOARD OF PUBLIC WORKS

SEWER DIVISION

Sketch of Service Here

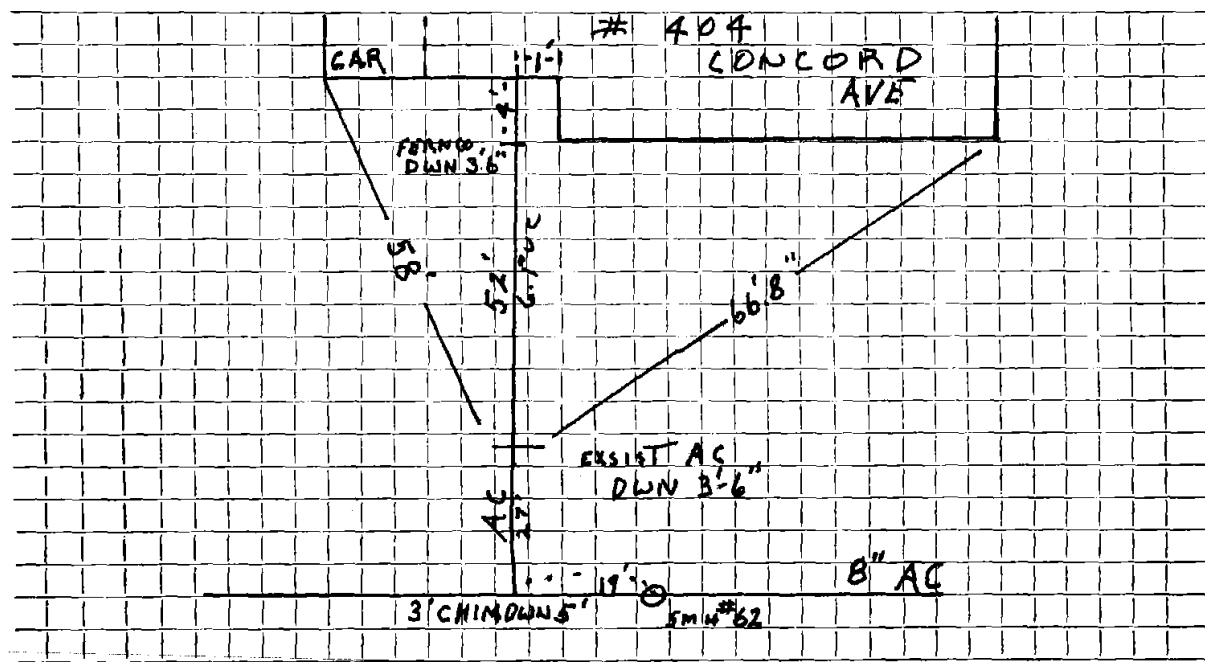

Connection made in CONCORD AVE Street. Work completed 12/99

Remarks:

.....

.....