

Name Norman Turnquist

Service No. 62

Address 405 Concord Ave.

Lot 36 Assessors Map 10

Location

Kind of Pipe

Size

Size of Main

~~Repair~~ ~~Renewal~~ New Service Trebino #3084

Location

NOV 13 1978

Date

Material

Amount

Total

Date


Amount

| | | | | | | | |
|-----------------|----------------|-------------------------------------|--|--------|--------------------|-------------|--------|
| 1971 | 22' | 6" transite pipe @ 12.00 | | 264.00 | 10-6-78 | Deposit | 264.00 |
| 10/17/78 | 28' | 6" Transite Pipe | | | | | |
| | 10' | 4" Cast Iron Pipe | | | 1971 | | |
| | | | | | 22' | 6" Transite | |

DATE _____

TOWN OF LEXINGTON — BOARD OF PUBLIC WORKS
SEWER DIVISION

Sketch of Service Here **405**

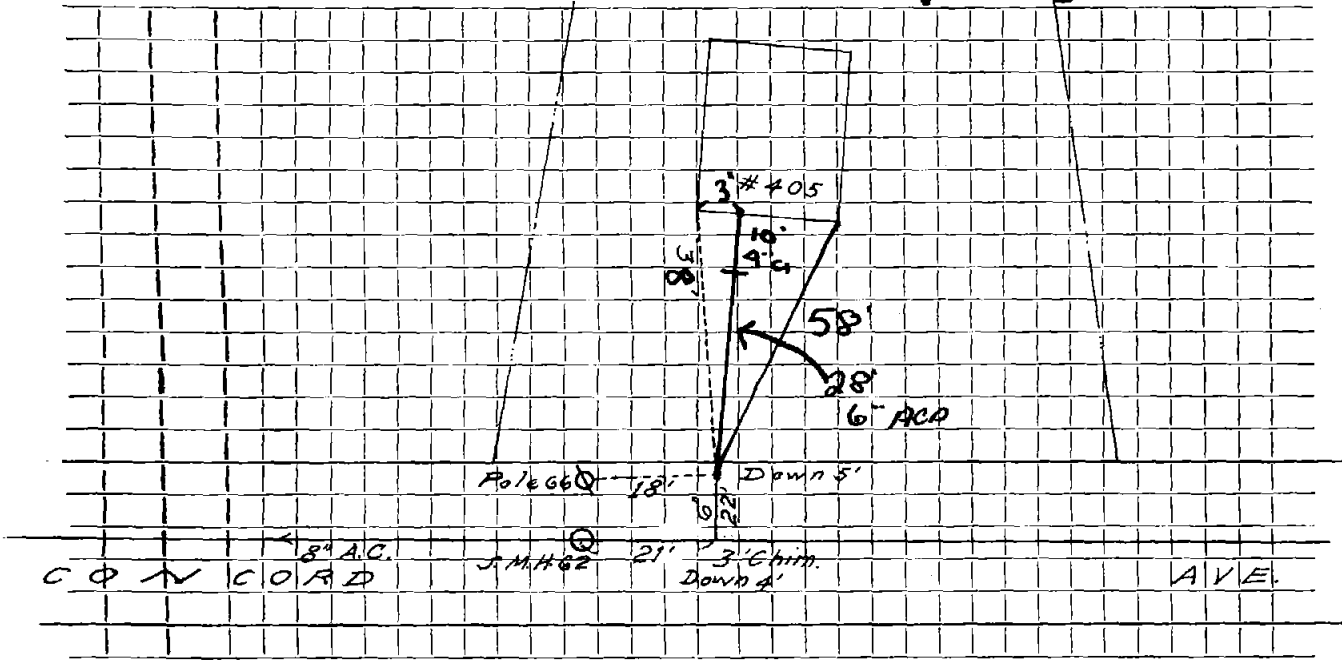

Connection made in Street. Work completed

Remarks:
.
.