

Name David J. Salto

Service No. 56

Address 416 Concord Ave.

Lots 2-B & 3

Location

Kind of Pipe

Size

Size of Main

~~REXXXXXXXXXXXX~~ New Service

Valeri#2323

Location NOV 19 1973


Date	Material	Amount	Total	Date	Amount	
<del>1971</del> 27	<del>6" transite pipe @</del>	12.00	324.00	6-18-73	Deposit	354.00
6/21/73	40' 6" Transite			1971		
	8' 4" Cast Iron			27	6" Transite	

DATE \_\_\_\_\_

TOWN OF LEXINGTON — BOARD OF PUBLIC WORKS  
SEWER DIVISION

Sketch of Service Here

**416**

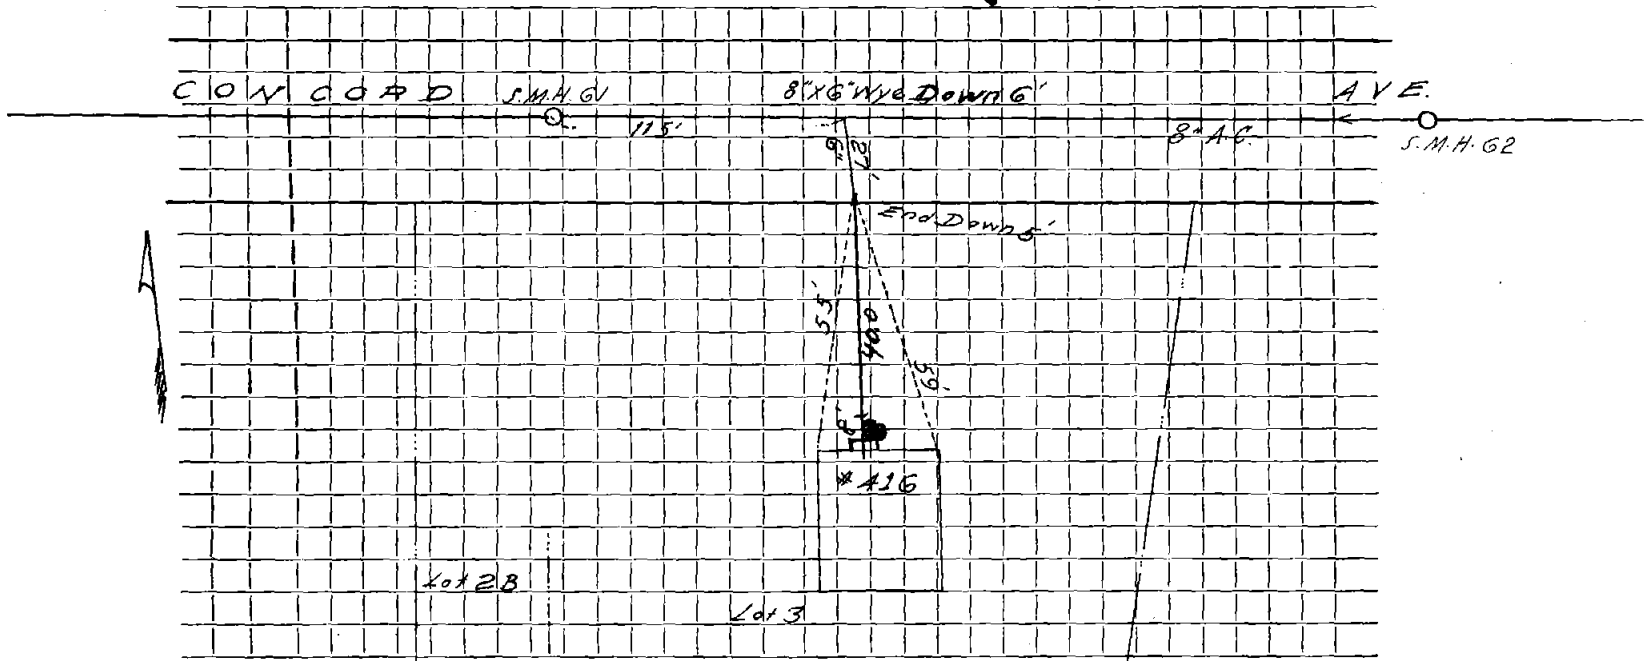

Connection made in ..... Street. Work completed .....

Remarks: .....  
.....  
.....