

Name John S. Mills, Jr.

Service No. 24

Address 429 Concord Ave.

Lot A

Location

Kind of Pipe

Size

Size of Main

Repair—Renewal—New Service Bonanno #2014

Location JUN 5 1972

Date	Material	Amount	Total	Date	Amount
------	----------	--------	-------	------	--------

1971	14.5' 6" transite pipe @	12.00	174.00	3-28-72	174.00
-----------------	-------------------------------------	------------------	-------------------	--------------------	-------------------

Deposit

174.00

4-12-72	131' 6" Transite pipe				
---------	-----------------------	--	--	--	--

	11' 4" Cast Iron pipe				
--	-----------------------	--	--	--	--


1971

14.5 6" Transite

DATE _____

TOWN OF LEXINGTON — BOARD OF PUBLIC WORKS

SEWER DIVISION

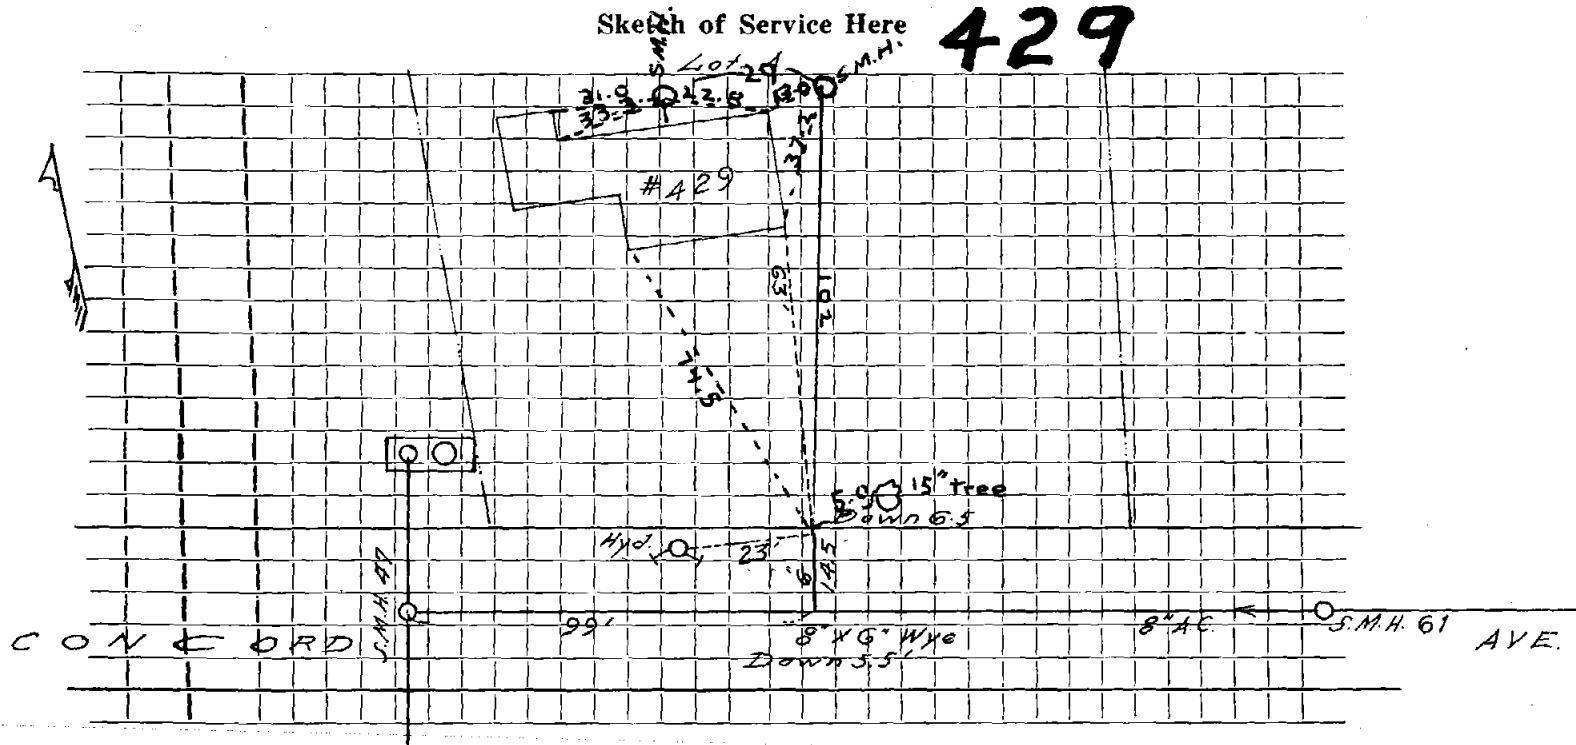

Connection made in Street. Work completed

Remarks:
.....
.....