

Name J. Sallars

Service No. _____

Address 430-432 Concord Ave

Location

Kind of Pipe 6' ACP

Size _____

Size of Main 10"

Repair—Renewal—New Service

Nick Bonanno permit ^{#2525} #2200 - #2366

Location _____


Date		Material	Amount	Total	Date	Amount
10-20-71		1 - Tee	N.C.			
10-18-	73	240' - 6" ACP				
		7' - 4" CI				
9/19/74	142'	6" Transite pipe				
	15'	4" Cast Iron pipe				

DATE _____

TOWN OF LEXINGTON — BOARD OF PUBLIC WORKS

SEWER DIVISION

Sketch of Service Here

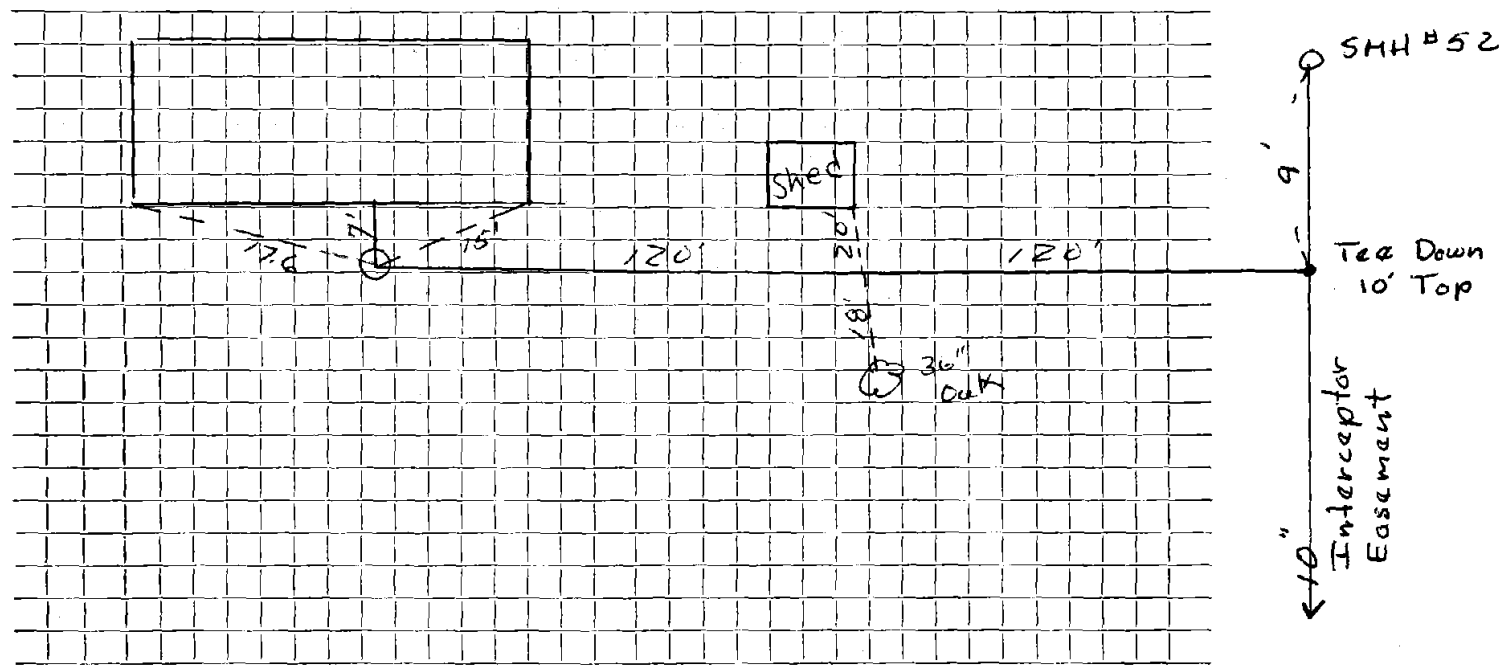

Connection made in Easement Street. Work completed

Remarks:

.....

.....