

Name

Service No.

Address *430 Concord Ave*

Location

Kind of Pipe

Size

Size of Main

Repair—Renewal—New Service

Location

Date

Material

Amount

Total


Date

Amount

<i>9/19</i>	<i>74</i>	<i>142' - 6" A.C.P.</i>							
		<i>15' - 4" C.I.</i>							

DATE _____

TOWN OF LEXINGTON — BOARD OF PUBLIC WORKS
SEWER DIVISION

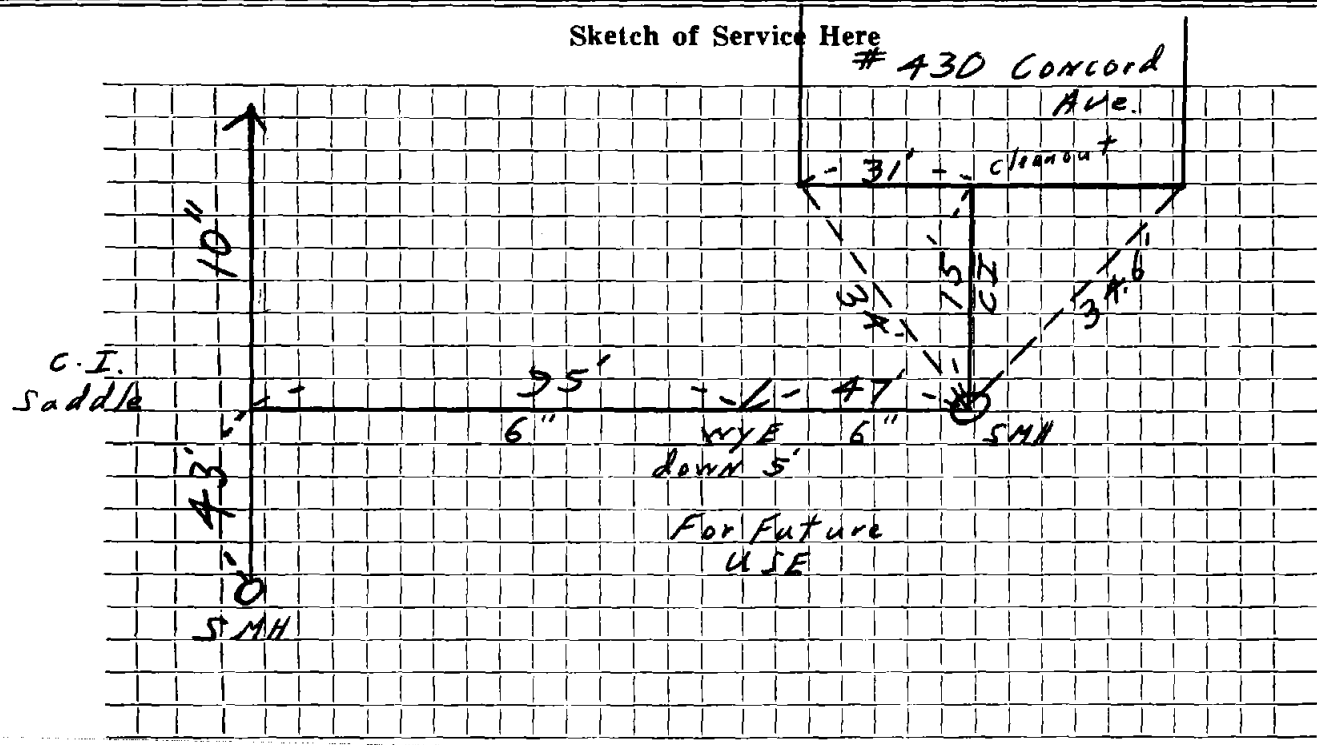

Connection made in Street. Work completed

Remarks:
.....
.....