

Name *Nicholas Reinhardt*

Service No.

Address *440 CONCORD AVE*

Location

Kind of Pipe *CI & PVC*

Size *4" & 6"*

Size of Main *10"*

Repair—Renewal—New Service *Kirkland # 0246*

Location

Date	Material	Amount	Total	Date		Amount
<i>2/7/93</i>	<i>11 LF 4" CI</i>			<i>68.93</i>	<i>paid</i>	<i>360.00</i>
	<i>44.5 LF 6" PVC</i>					
	<i>4x6" FERRO</i>			<i>1991</i>		
	<i>6x6" FERRO</i>			<i>30'</i>	<i>6" TRANSITE</i>	
	<i>6"x6" WYE C. O.</i>					
	<i>6" 45° ELBOW</i>					
	<i>6" 22° ELBOW</i>					
<i>1991</i>	<i>30' 6" TRANSITE @ 12.00</i>		<i>360.00</i>			

Name Louise Frey

Service No.

Address 440 Concord Ave.

Lot L.C. 14

Location

Kind of Pipe

Size

Size of Main

Repair—Renewal—New Service

Location

Date	Material	Amount	Total	Date	Amount
1971	30' 6" transite pipe @ 12.00		360.00	6-8-24	360.00 Paid

DATE _____

TOWN OF LEXINGTON — BOARD OF PUBLIC WORKS
SEWER DIVISION

Sketch of Service Here



Connection made in Street. Work completed

Remarks:
.....
.....


DATE _____

TOWN OF LEXINGTON — BOARD OF PUBLIC WORKS

SEWER DIVISION

Sketch of Service Here

440

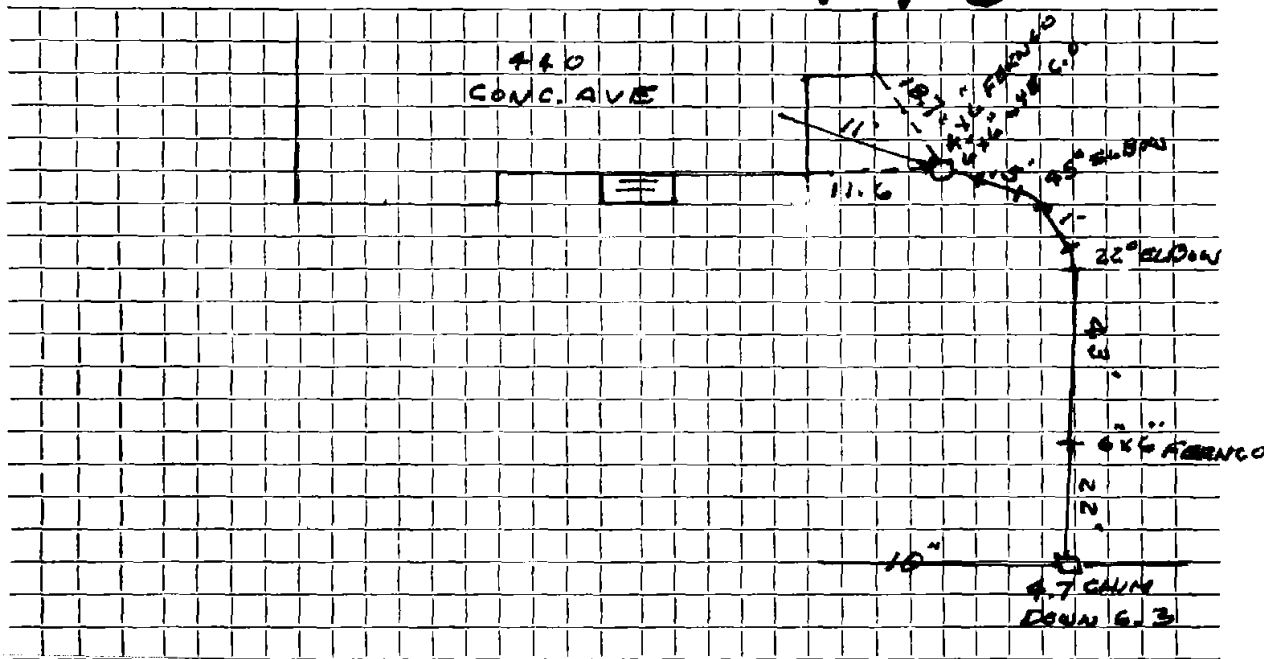

Connection made in CONCORD AVE Street. Work completed

Remarks: KIRKLAND & SHAW RE-PLACED 8" 6" ACP

.....
.....