

Name *Jessie Barker*

Service No. 95

Address *447 Concord Ave.*

Assessors Lots # *10/42*

Location

Kind of Pipe

Size

Size of Main

~~Repair~~ ~~Renewal~~ ~~New Service~~

*Trebino #3206*

Location


*DEC 26 1978*

Date	Material	Amount	Total	Date	Amount
<del>1971</del>	<del>13' 6" Transite Pipe @12.00</del>		<del>156.00</del>	<i>11-15-78</i>	<i>Deposit</i>
<i>12/5/78</i>	<i>56' 6" Transite Pipe</i>				
	<i>5' 4" Cast Iron Pipe</i>			<i>1971</i>	
				<i>13' 6" Transite</i>	

DATE \_\_\_\_\_

TOWN OF LEXINGTON — BOARD OF PUBLIC WORKS  
SEWER DIVISION

Sketch of Service Here **447**

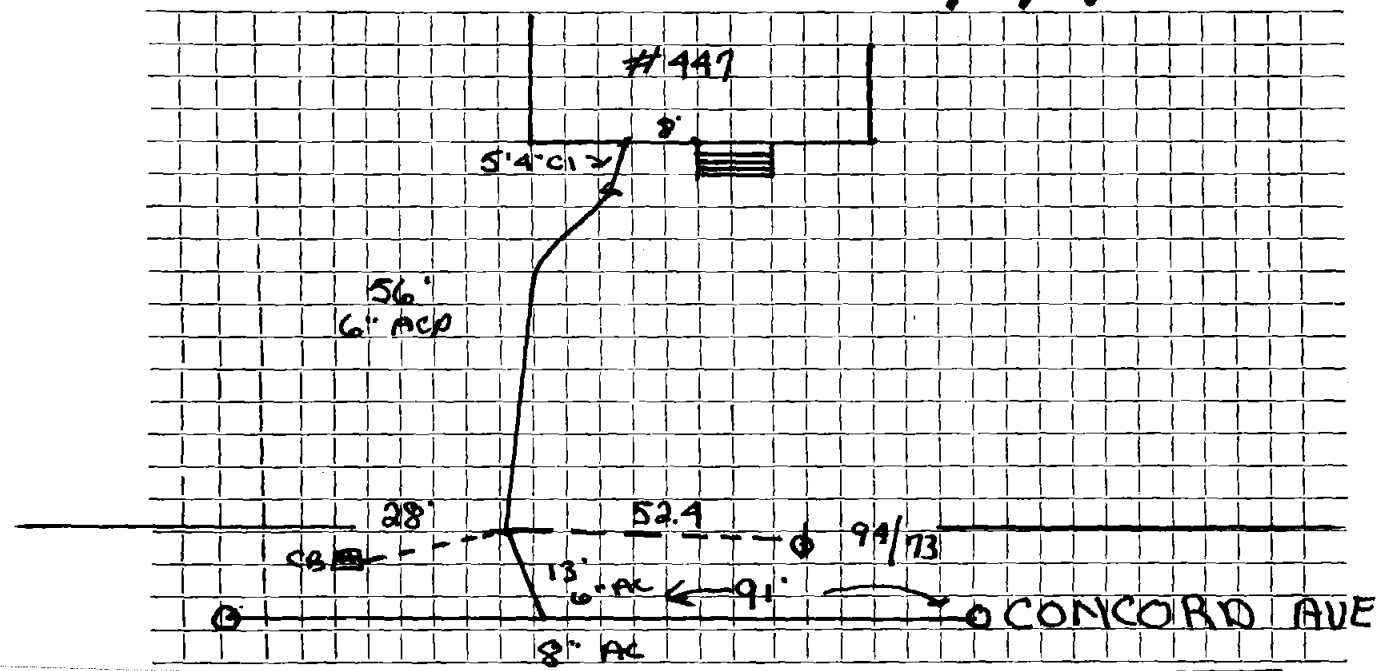

Connection made in ..... Street. Work completed .....

Remarks: .....  
.....  
.....