

753

Name Ida G. Krebs

Service No. 54

Address 453 Concord Avenue
Kreb's School - Concord Ave. A53
Lots L.C. A5-L.C. A12

Location

Kind of Pipe

Size

Size of Main

Repair—Renewal—New Service Valeri #2056

Location JUN 5 1972


Date	Material	Amount	Total	Date	Amount
1971	27' 6" transite pipe @	12.00	324.00	5-1-72	324.00
					<i>Deposit</i>
5-17-72	393' 6" Transite pipe				
	19' 4" Cast Iron pipe			1971	
				27'	6" Transite

DATE _____

TOWN OF LEXINGTON — BOARD OF PUBLIC WORKS
SEWER DIVISION

Sketch of Service Here

453

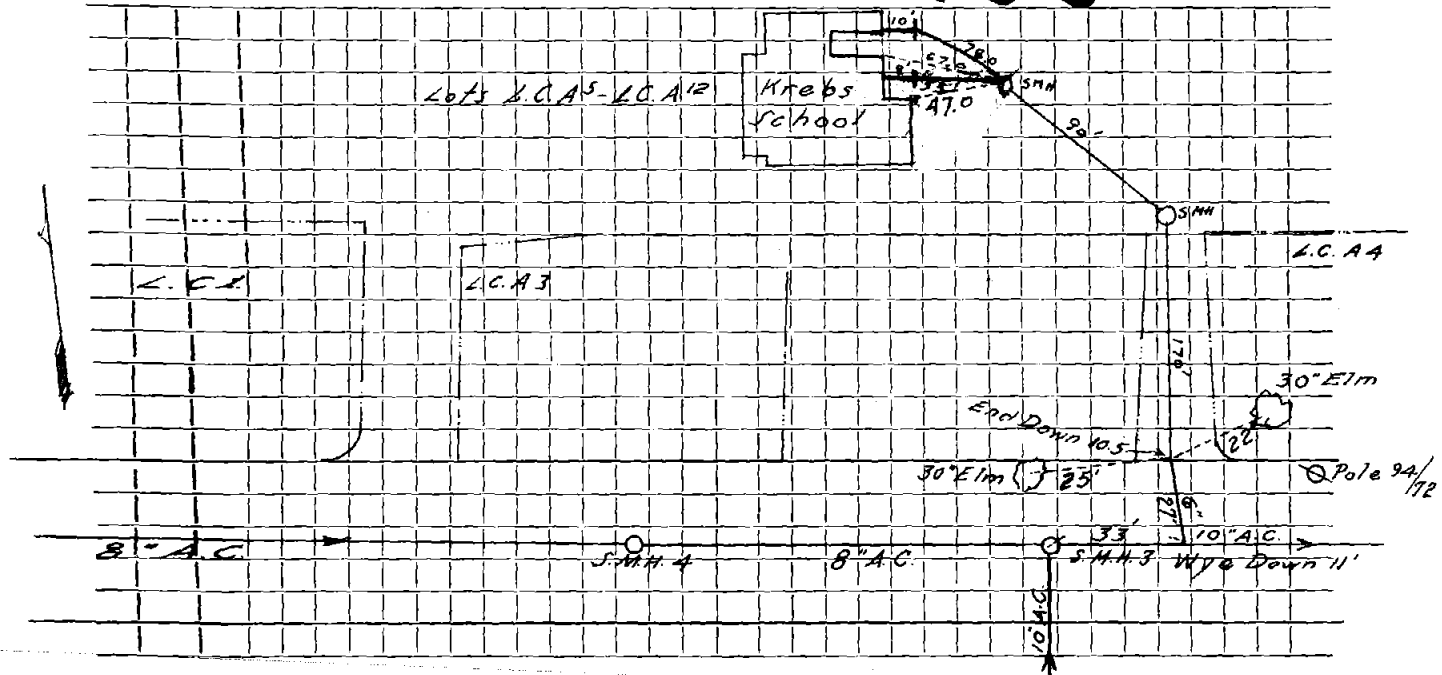

Connection made in Street. Work completed

Remarks:
.
.