

Name

Service No.

Address

456 Concord Ave.

Lot L.C. 12

Location

Kind of Pipe

Size

Size of Main

Repair—Renewal—New Service

Location

Date

Material

Amount

Total

Date

Amount

~~1971~~ ~~25'~~ ~~6" transite pipe @ 12.00~~

300.00


1971

25' 6" Transite

DATE _____

TOWN OF LEXINGTON — BOARD OF PUBLIC WORKS
SEWER DIVISION

Sketch of Service Here **456**

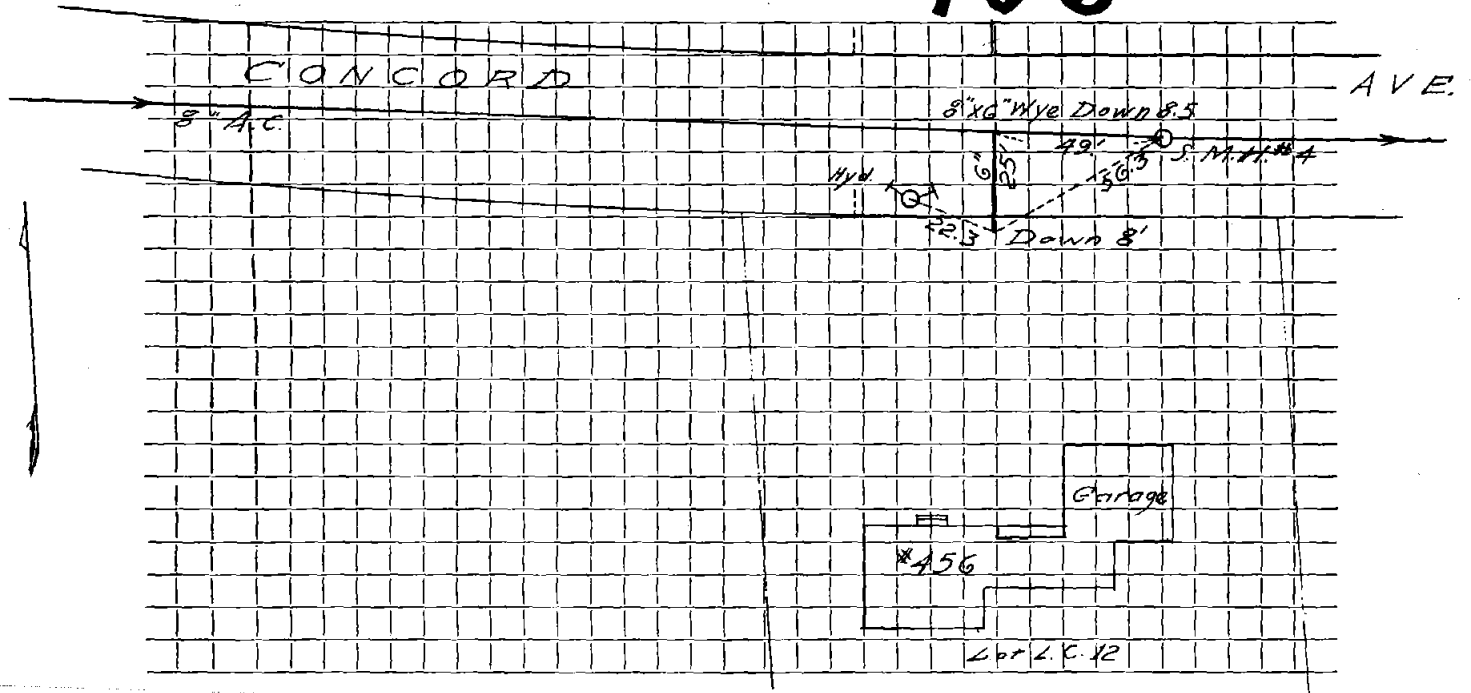

Connection made in Street. Work completed

Remarks:
.....
.....