

Name Martin Lubin

Service No. 131

Address 461-463 Concord Ave.

Lot L.C. 1

Location

Kind of Pipe

Size

Size of Main

Repair—Renewal—New Service Valeri Const. # 2401

Location

APR 8 1974

Date	Material	Amount	Total	Date	Amount
------	----------	--------	-------	------	--------

1971	16' 6" transite pipe @ 12.00		192.00	9-28-73	Deposit	192.00
------	------------------------------	--	--------	---------	---------	--------

11-26-73	112' - 6" ACP					
	10' - 4" CI					

REPAIR

GARAGE END OF HOUSE (Valeri #4356)

4/24/86	4' 10" 6" PVC Pipe					
12/22/86	53' 6" PVC			2	6 x 6 PVC Trans Fernco	
	1 6" Wye			1	22 1/2 Bend PVC	

	2 22° Sweep					
	1 4" x 6" Fernco					

DATE _____

TOWN OF LEXINGTON — BOARD OF PUBLIC WORKS

SEWER DIVISION

Sketch of Service Here

461-463


Lot L.C.1

REPAIR
4/24/86

6x6 PVC TRANS FERNCO
4'10" 6" PVC X
22 1/2° BEND
6x6 PVC TRANS FERNCO

REPAIRED
4/24/86

- 2 - 6x6 PVC-TRANS FERNCO
- 1 - 22 1/2° BEND PVC
- 4'10" 6" PVC PIPE

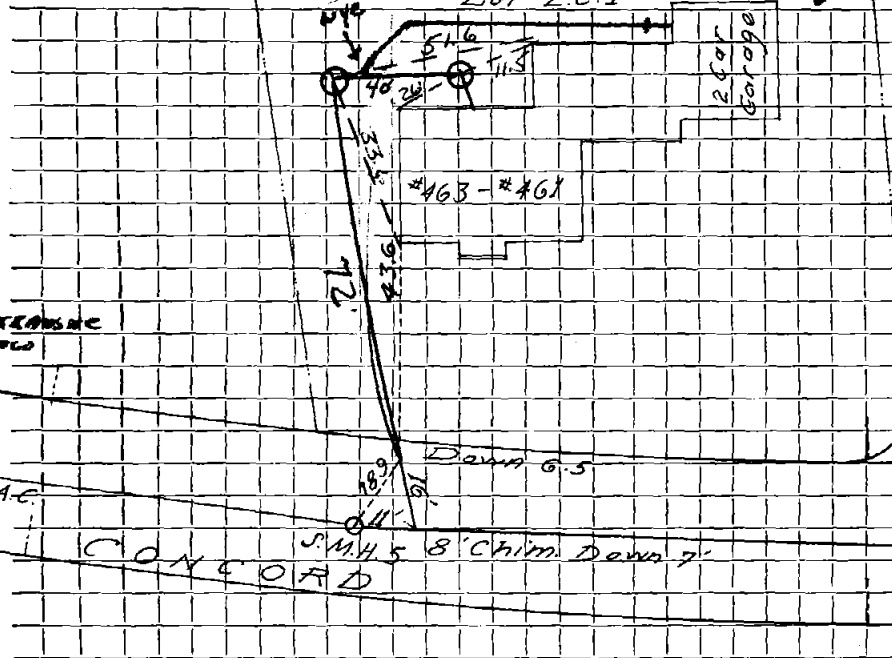

Connection made in Street. Work completed

Remarks: See INSPECTION For Ties

.....
.....