

Name Leonard Hecker

Service No. 65

Address 464 Concord Ave.  
 Lot L.C. 71

Location

Kind of Pipe

Size

Size of Main

Repair—Renewal—New Service Valeri #2326


Location NOV 19 1973

Date	Material	Amount	Total	Date	Amount
<del>1971</del>	<del>28.8' 6" transite pipe @</del>	<del>12.00</del>	<del>345.60</del>	<del>7-13-73</del>	<del>345.60</del>
7/17/73	110' 6" Transite pipe				
				1971	
				28.8'	6" Transite

DATE \_\_\_\_\_

TOWN OF LEXINGTON — BOARD OF PUBLIC WORKS

SEWER DIVISION

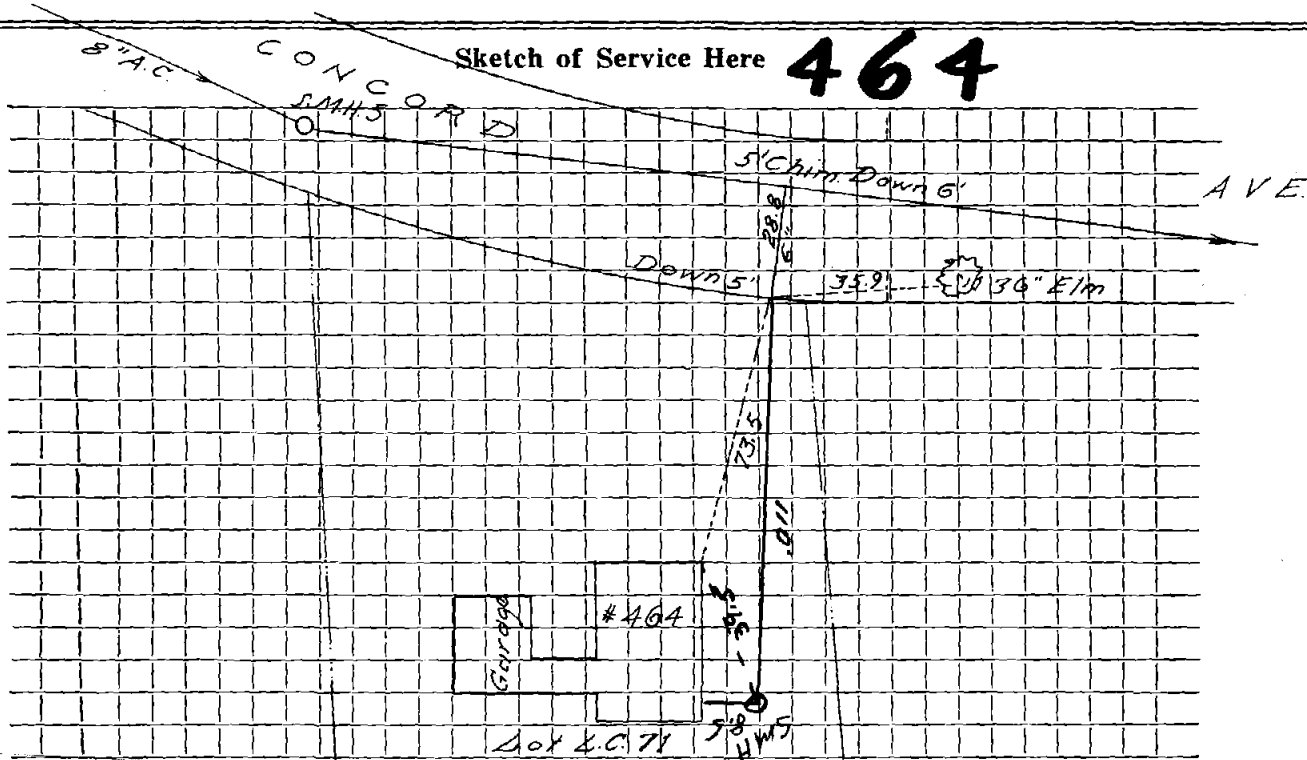

Connection made in ..... Street. Work completed .....

Remarks: .....  
.....  
.....