

Name *Frank Fotis*

Service No.

Address *473 Concord Ave.*

Lot B

Location

Kind of Pipe

Size

Size of Main

Repair—Renewal—New Service *Valeri #4760*

Location

Date

Material

Amount

Total

Date

Amount

~~1971~~ ~~17.5'~~ ~~6" transite pipe @ 12.00~~

210.00

4-3-89

Deposit

210 00

1989 58' 6" PVC

1971


17.5' 6" Transite

DATE _____

TOWN OF LEXINGTON — BOARD OF PUBLIC WORKS

SEWER DIVISION
473 CONCORD AVE

Sketch of Service Here

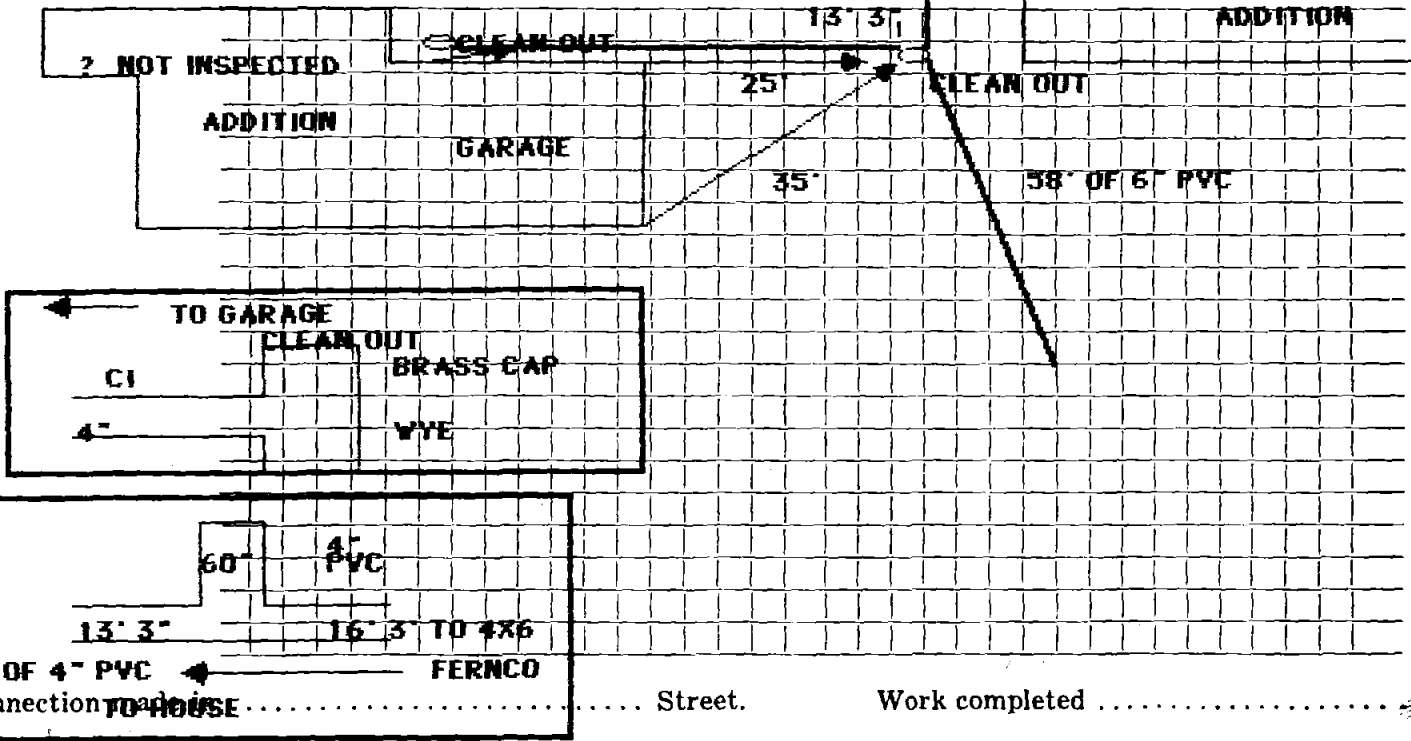

Connection TO HOUSE Street. Work completed

Remarks:

.....

.....

DATE _____


TOWN OF LEXINGTON — BOARD OF PUBLIC WORKS SEWER DIVISION

Sketch of Service Here

473

Lot A

Lot B

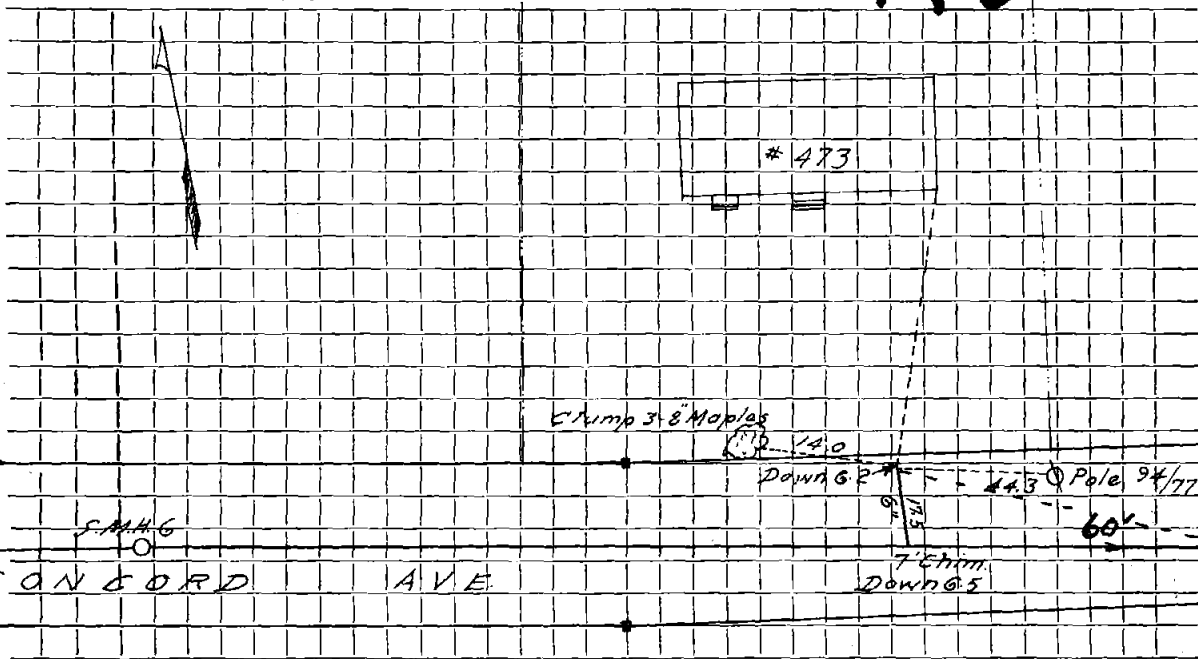

CONCORD AVE

BARBERRY Rd.

Connection made in Street. Work completed

Remarks:
.....
.....